

MISSISSIPPI DEPARTMENT OF NATURAL RESOURCES

Bureau of Land and Water Resources

Southport Mall

P.O. Box 10631

Jackson, Mississippi 39209

WATER WELL DRILLERS LOG

HINDS
N88
2/28/83

2-28 1983 Parks & Parks Well Serv. Inc. Hinds
 date well completed firm name county well located

LANDOWNER:	description of formations encountered	from	to
Mississippi Museum of Natural Sciences (mailing address) Jackson, Miss.	Clay	0	200
	Sand & Clay	200	245
	Clay	245	500
	Shale w/ sandy sub	500	600
	Sand (shale)	600	766
WELL LOCATION: sec. <u>3</u> T. <u>5N</u> R. <u>1E</u> 111 N. Jackson St. (distance) miles (direction) of (nearest town) Jackson, Miss.			
WELL PURPOSE: (home, irrigation, municipal, industrial)			
WELL COMPLETION DATA: (1) diameter (inches) <u>4"</u> (2) total depth (feet) <u>702</u> (3) static water level (feet) <u>184</u> below above top of ground. (4) casing <u>Steel</u> <u>590'</u> (material) (depth) <u>4x2</u> if telescope see back. (size) (5) screen <u>25'</u> <u>699'</u> (length) (depth to top) <u>2"</u> <u>Stainless</u> (size) (material) (6) pump <u>5</u> <u>50</u> (HP) (yield gpm) (type power) (7) electric log <u>No</u> (yes or no) (organization running log) (8) how well bottom plugged <u>2" BPR</u>			

Replacement of casing

CODED

DEPT. OF NATURAL RESOURCES
 BUREAU OF LAND & WATER RESOURCES

APR 18 1983

RECEIVED

DRILLERS REMARKS:


3218061090110207

If well telescopes please sketch and show depths.

SECTION _____

Please indicate well location X.

ADDITIONAL INFORMATION

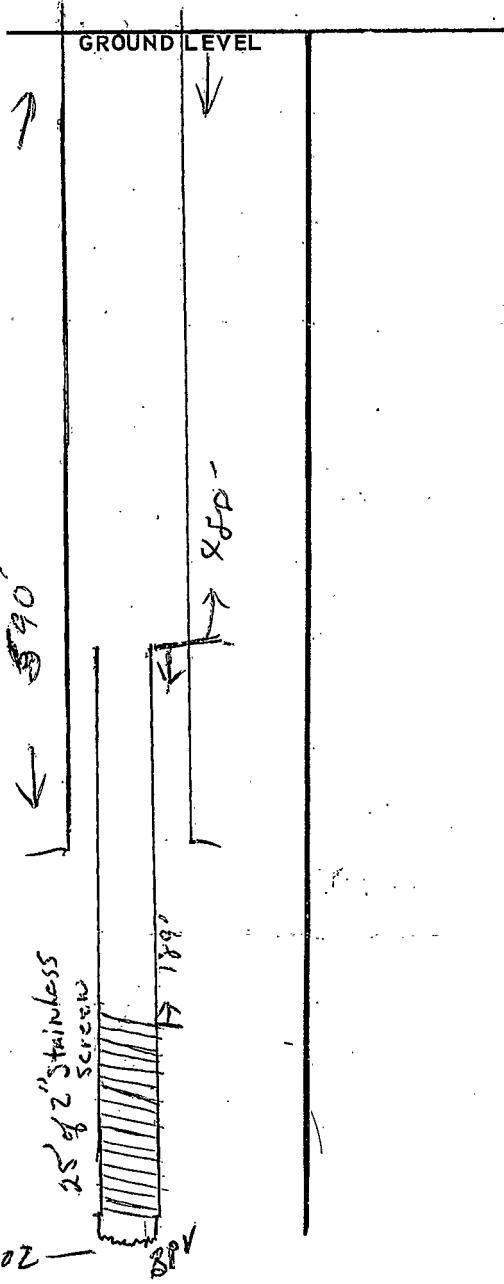

If more than one screen, show locations of each on sketch.