

MISSISSIPPI DEPARTMENT OF NATURAL RESOURCES

Bureau of Land and Water Resources

P.O. Box 10631

Jackson, Mississippi 39209

WATER WELL DRILLERS LOG

COUNTY WELL LOCATED Hinds	
WELL NUMBER N 94	CODED <input checked="" type="checkbox"/>
DATE WELL COMPLETED 4-30-96	

PERMIT NUMBER 510
NAME OF DRILLING FIRM Easley Water Wells
Brookhaven, MS 39601

NAME & MAILING ADDRESS OF LANDOWNER Rosemont Gardens Cemetery			
WELL LOCATION:	SEC	TOWNSHIP	RANGE
Hinds	32	5	(N) 1 (E) S W
DISTANCE	DIRECTION	NEAREST TOWN	
	Miles	of	
OTHER LANDMARK			
WELL PURPOSE: Home, Irrigation, Municipal, Industrial, Fish Pond, etc.			

PUMP DATA		
PUMP TYPE (Circle One): <u>Submersible</u> Turbine, Jet, Flowing Well, Other (Describe) _____		
POWER TYPE (Circle One): <u>Electric</u> Tractor, Diesel, Gasoline, Butane, Other (Describe) _____		
Pump Capacity (GPM)	No. of Stages	Setting Depth FT.
PUMP TEST		
Well yielded _____ GPM with a drawdown of _____ ft. after _____ hours of pumping		


WELL DATA		
Well Depth 775'	Casing Diameter (In.) 4"	Casing Length (Ft.) 620
Type of Casing PVC	Hole Depth 775'	Depth to Static Water Level
TYPE OF COMPLETION: (Circle One or More): <u>Natural Development</u> , Underreamed, Telescoped, Gravel Packed, Open Hole, Other (Describe) _____		
Top of Lap Pipe or Reduction in Casing FEET IF TELESCOPED OR MORE THAN ONE SCREEN: USE BACK PAGE		

LOG DATA	
TYPE OF LOG RUN (Circle One): No Log Run, Electric, Gamma Ray, Density, Sonic, Neutron, Other (Describe) _____	
Name of Organization Running Log	

SCREEN DATA		
Diameter - Inches 4"	Length - Feet 80	Slot-Size - Inches 8
Screen Type PVC	Depth to Bottom - Feet 640	

GEOLOGIC DATA (Office Use Only)			
Surface Elev.	Geologic Unit	Unit Thickness	Depth to Top
Subs. SWL	Date	Analysis	Aquifer Test

Driller's Remarks

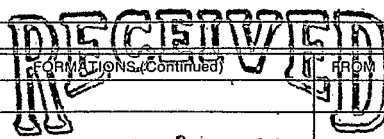


DESCRIPTION OF FORMATIONS ENCOUNTERED	FROM	TO	FORMATIONS (Continued)	FROM	TO
Clay	0	590			
Sand	590	610			
Clay	0	590			
Sand	590	610			
Clay	610	690			
Sand	690	740			
Clay	740	775			

IF MORE SPACE IS NEEDED, USE BACK

If well telescopes please
sketch and show depths.

GROUND LEVEL

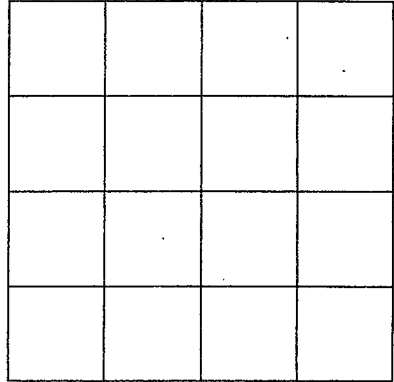

SECTION _____

Please indicate well location X.

ADDITIONAL INFORMATION

If more than one screen,
show location of each on sketch.