
County: <u>Hinds</u> Permit #: <u>WWC-0565</u> Driller: <u>Greg Adams</u> Date drilling completed: <u>2-21-2006</u>	Well Driller Report and Well Log Mississippi Department of Environmental Quality Office of Land and Water Resources P.O. Box 10631 Jackson, MS 39289-0631 (601)961-5210 (601)354-6938 (fax)	For Office Use Only:    Aquifer:			
State Law requires that this re 30 days of completion of drillin	port be prepared by the driller in detail and filed w ig of the well.	ith the Department within			
Well Owner Inform	ation W	ell Location			
Owner Name Allied William	ns Latitude: 32 . 15 . 41	Latitude: 32 . 15 , 41.7 " Longitude: 90 . 12 , 39.6 "			
Mailing Address: P.O. Box	16667 Method of Lat/Long (circle	one): Conventional Survey,			
	USGS guad Hand-he	eld GPS, Survey-grade GPS			
Mobile A		$0^{\prime}$ Twn 5N Rng 1E			
	State Zip Code				
Telephone No. (251) 450-	2797 Distance Direction	Distance Direction Nearest Town			
	Well Data				
Purpose of Well (circle one) Home In	ndustrial Public Supply Irrigation Fish Cultu	ire Other: Monitoring			
	Date well drilling completed:				
	Valve <u>V/A</u> Other (describe) <u>V</u>				
Static Water Level: <u>165</u> feet	above or below (circle one) land surface Date meas	ured: 2-23-2006			
	steel tape electric tape air line other:				
Hole depth: 220' Well d	lepth: 195' Well grouted to a depth				
Type of grout (circle one): Cement	Bentonite Mix				
215	2	AVC			
	sing diameter: inches Type of casi				
	reen diameter:inches Type of scree	en: <u><u></u><u></u><u></u><u></u><u></u><u></u><u></u><u></u><u></u><u></u><u></u><u></u><u></u><u></u><u></u><u></u><u></u><u></u><u></u></u>			
Screen slot size: 0.010 inches	Setting depth: Fromfeet to	215feet			
Type of completion (circle all applicable)	): Gravel packed Underreamed Telescoped	Open hole Natural Development			
	Other (describe):	Packed			
Γop of lap pipe or reduction in casing:	N/A feet. If telescoped or more than on	e screen, describe on back of page			
Logs run (circle all applicable): No log r	un Electric Gamma Ray Density Sonic Neutr	on Other: SP, Resistluity			
Name of organization running log(s):	MS OFFice of	- Geology			
certify that the well was drilled, constructed, an	nd completed in accordance with all applicable requirements of t	the Mississippi Department of			
Sava onmental Quanty and/or the Mississippi De	epartment of Health regulations and state laws.				
$\land$	11				
Gomer Wallace, Wh	1C-0565 June 10	allow			

If well telescopes please sketch below and show depths.

MAR 1 5 2006 BY: OLWR

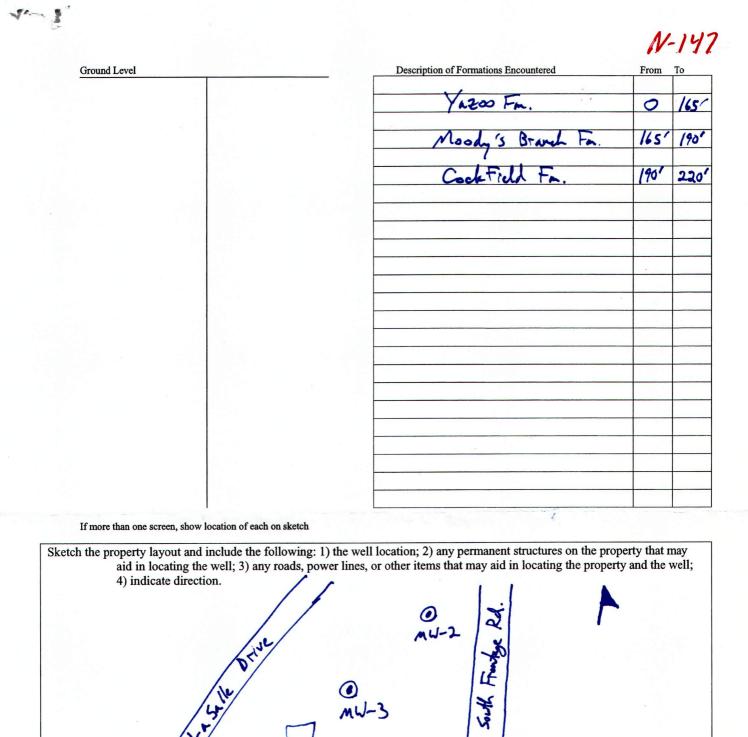

MW-3

ローチ

Landowner Name:

Allied Williams

Signature of Water Well Contractor

RECEIVED MAR 1 5 2006 BY: OLWR

01/16/2007 13:36 FAX 6019569533

Received Fax : Jan 16 2007 1:37PM Fax Station : MDEQ LAND & WATER

AQUATERRA

n. 3

PROJECT: Post Remediation Monitoring Former Terminix Facility					BORING INSTALLATION LOG			DG	FILE: DATE:	524115 1/24/06		
	Jackson, MS	6					No. B/MW-3		DRILLER:	G. Adams		
CLIENT:	Allied-Williar	ns. Inc.							TECH.:	C. Fancher		
OEIENT.	Mobile, Alab						SHEET 1 OF 1	T	GEOLOGIST:			
FIELD DATA LABORATO				ORY	DAT.		INSTALLATION DETAILS	Location: Fom Rd.				
Depth of Mag	Field	(pct			priter	astici					Strata Breal Soil Type	
(teet) Samples Groundwater	v Results	Moist	Dry		<u>₹0</u>	ă			DESCRIPT	ION	Strat	
ເບັນ	<u>م</u>	├+			мси	. P1		Medium dense		AYEY SAND (SC)		
							8" Casing set to 10'	(Fill)				
							Riser: 0 - 200'── Benionite Grout: 0 - 188'─→	- slickensided - blocky - Yazoo Clay - very stiff bel	ow 20'	(CH) nodules below 26'		
	<b>Z</b>						Bentanite Pellets: 188' - 190' 188 0 07. 190 0 0	SAND (SC) - Moody's Br	anch	onitic CLAYEY	165.0	
200- 200- 200-							Sand: 190'-220'-200.0 200.0 Screen: 200'-220'-	- Cockfield F	CLAYEY SAN ormalion	- \/	220.0	
220-			╞╴╌┼╸		┼╺╃	· -	220.0	₩B	oring Termina	ted at 220'		
		_ <u>_</u>						Notes	STPATA BOUNDARES &	AY NOT BE DUCT		
Groundwater Level Data Groundwater Level Data Torow 167.42' at time of groundwater sampling					' - 220	': Rol	Advancement Method nt-flight Auger ary Wash Well Construction Notes II MW-3 set upon completion of boring			Jaren	<b>172)</b> 7 5	