

Hinds
N 3001
6-66

MISSISSIPPI BOARD OF WATER COMMISSIONERS

WATER WELL DRILLERS LOG

Date: 6/24, 1966, Driller: Paul Drilling Co. (Hinds)
(Name)

(1) Owner of Land: Johnson - Arroyo
Arch Best System
(Name)
Jackson, Miss
(Address)

(2) Location: 1/4, 1/4, Sec. 10E
3 miles South of Jackson
(distance) (direction) (Nearest Town)
on Hwy 55
(Flat) (Level)

(3) Topography: 2nd
(Hilly) (Flat) (Level)

(4) Purpose of Well: 2nd
(Domestic Irrigation
Municipal, Industrial, Other)

Information upon completion of well:

(1) Diameter: 4 x 2 1/2 inches.

(2) Total Depth: 1275 feet.

(3) Water Level: 135 feet below top of ground. 1245

(4) Cased to: 1240 feet, Size 15 1/4" - 2 1/2"


(5) Screen: Size 2 1/2", Length 30 ft

(6) Were any formations sealed against pollution?
no

If YES depth of formation

Why

Drillers Remarks:

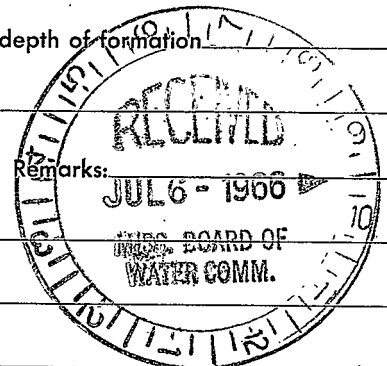

Description & Color of Materials Sand, Clay, Red Clay, Shell, etc.	Thick- ness Feet	Depth Feet
Clay		35
Sand		40
Blue Clay		307
Shale + Sths Rock		420
Shale		579
Shale + Sths Silt		553
Shale		572
Rock		574
Shale + Silt		605
Fine sand + shale		633
Fine sand		643
Shale		646
Fine sand		659
Shale		674
Hard Shale		694
Shale		776
Shale + Sths Rock		786
Shale		816
Shale + Sths Rock		836
Shale + Rock		856
Shale		876
Soft Shale		916
Soft shale + Sths Rock		936
Sh Sand + Shale		956
Shale + Sths Sand		986
Fine sand		961
Shly lignite + sand		971
Sand		976
Shale + Sths Sand		991
Fine sand		996
Shale + Sths Sand		1016
Shale		1127

Well No. 710

(Use Back Side)

Book + 5th Sunday 1147
Shut + 4th Sunday 1173
Book
Book + 5th Sunday 1220
Book + 5th Sunday 1227
Book + 5th Sunday 1275