

Hinds  
 029  
 4-67  
 EICC Log  
 4-27-67

MISSISSIPPI  
 BOARD OF WATER COMMISSIONERS CODED  
 416 North State Street  
 Jackson, Mississippi 39201

WATER WELL DRILLERS LOG


James D McNEES Hinds  
 date well completed firm name county well located

LANDOWNER:  
 A.G. Wiesmann  
 Magnolia Road  
 (mailing address)  
 WELL LOCATION:  
 sec 35 T 4 N R 4 E  
 4 miles N of UTICA  
 (distance) (direction) (nearest town)

description of formations encountered	from	to
SURFACE SOIL	0	5
SAND-CLAY	15	30
Grey sdy sh	30	210
SAND	210	212
Grey sh sd str	212	223
SAND	223	257
Grey sdy sh	257	283

WELL PURPOSE: HOME  
 (home, irrigation, municipal, industrial)


WELL COMPLETION DATA:  
 (1) diameter (inches) 4" x 2"  
 (2) total depth (feet) 283'  
 (3) static water level (feet) 88 below top of ground.  
 (4) casing steel (material), (depth)  
 4" x 2" (size) if telescope see back,  
 (5) screen 10' 241 (length) (depth to top)  
 2" stainless steel (size) (material)  
 (6) pump 1 16 (HP) (yield gpm)  
 Elec (type power)  
 (7) electric log Yes (yes or no)  
 M.G.S. (organization running log)  
 (8) how well bottom plugged mud

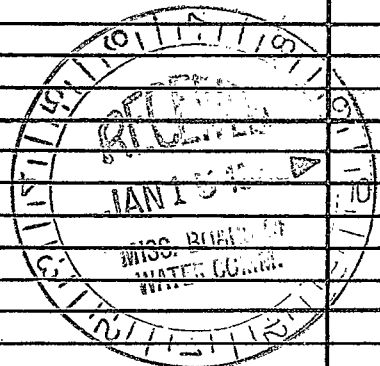

DRILLERS REMARKS:  
 Water clear

If well telescopes please sketch and show depths.

GROUND LEVEL

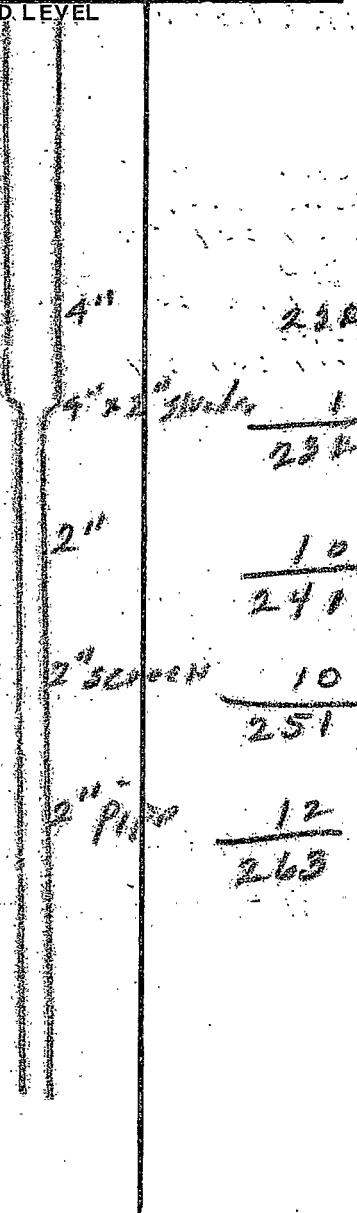

X			

SECTION 35

Please indicate well location X.

ADDITIONAL INFORMATION

If more than one screen, show locations of each on sketch.