

25 5

Hinds
D30
9-69

MISSISSIPPI
BOARD OF WATER COMMISSIONERS
416 North State Street
Jackson, Mississippi 39201

CODED

WATER WELL DRILLERS LOG

9/4 1969 BIG BLACK DRILLING CO. HINDS
date well completed firm name county well located

LANDOWNER:
FRED FAULK
P.O. Box ? EDWARDS
MISS.
(mailing address)

description of formations encountered	from	to
BROWN CLAY	0	15
RED CLAY SAND	15	35
WHITE / "	35	45
" CHALK	45	55
WHITE SAND	55	95

WELL LOCATION:
sec. 2 T. 14 N R. 5 E
S W
APPROX. 12 miles S.E. of VICKSBURG
(distance) (direction) (nearest town)

WELL PURPOSE: HOME
(home, irrigation, municipal, industrial)


- WELL COMPLETION DATA:
- (1) diameter (inches) 2"
 - (2) total depth (feet) 95
 - (3) static water level (feet) 86' below top of ground.
 - (4) casing 2" GALV. (material), 87' (depth)
 - (size) If telescope see back.
 - (5) screen 86' (length), 89' (depth to top)
 - 1/4" (size), 60 GAUSE (material)
 - (6) pump 1 (HP), 10 (yield gpm)
 - ELECTRIC (type power)
 - (7) electric log NO (yes or no)
 - (organization running log)
 - (8) how well bottom plugged CAPPED

DRILLERS REMARKS:

SEP 8 1969
MISS. Bd. of WATER COMMISSIONERS

If well telescopes please sketch and show depths.

GROUND LEVEL

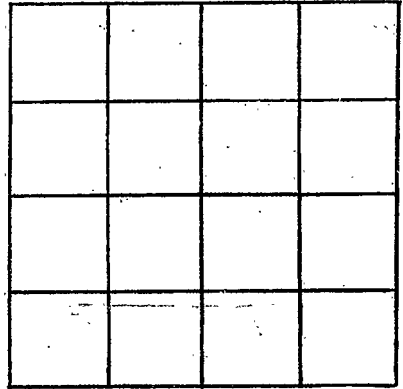

SECTION _____

Please indicate well location X.

ADDITIONAL INFORMATION

If more than one screen, show locations of each on sketch.