

CODED

MISSISSIPPI  
BOARD OF WATER COMMISSIONERS  
416 North State Street  
Jackson, Mississippi 39201

HINDS  
0 37  
12- 69

WATER WELL DRILLERS LOG

December 1969 Feb Joe Hinds  
date well completed firm name county well located

LANDOWNER: John H  
Cessna  
Rt 2 Box 113 Utica Miss  
(mailing address)

description of formations encountered	from	to
<u>Br &amp; White cl</u>	<u>0</u>	<u>24</u>
<u>Gravel &amp; cl</u>	<u>24</u>	<u>30</u>
<u>Blue cl</u>	<u>30</u>	<u>109</u>
<u>S. Rock &amp; Blue cl</u>	<u>109</u>	<u>155</u>
<u>Fine sd -</u>	<u>155</u>	<u>170</u>
<u>Sd cl</u>	<u>170</u>	<u>230</u>
<u>Sd -</u>	<u>230</u>	<u>250</u>

WELL LOCATION:  
sec. 10 T. 14 N R. 5 E  
12 miles NW of Utica  
(distance) (direction) (nearest town)

WELL PURPOSE: Home  
(home, irrigation, municipal, industrial)


- WELL COMPLETION DATA:
- (1) diameter (inches) 4 1/4
  - (2) total depth (feet) 250
  - (3) static water level (feet) 43 below top of ground.
  - (4) casing Galv. 240  
(material) (depth)
  - (size) if telescope see back.
  - (5) screen 10 240  
(length) (depth to top)
  - 2 SS  
(size) (material)
  - (6) pump 1 8  
(HP) (yield gpm)
  - Elec  
(type power)
  - (7) electric log No  
(yes or no)
  - None  
(organization running log)
  - (8) how well bottom plugged B.W.U.

DRILLERS REMARKS:

Feb.  
3 - 1970  
MISS. RD. OF  
WATER BOARD

If well telescopes please sketch and show depths.

GROUND LEVEL

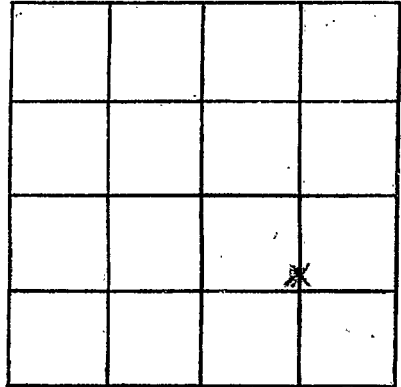

SECTION 10

Please indicate well location X.

ADDITIONAL INFORMATION

If more than one screen, show locations of each on sketch.