

HINDS
 Ø 38
 10-12-67

MISSISSIPPI
 BOARD OF WATER COMMISSIONERS
 416 North State Street
 Jackson, Mississippi 39201

CODED

WATER WELL DRILLERS LOG

10/12 1967 *South Drilling Co.* Hinds
 date well completed firm name county well located

LANDOWNER: *John Jackson*
RH-Box 559
Edwards, Miss.
 (mailing address)

WELL LOCATION:
 sec. *35 T 14 N R 4 W*
8 miles *S W* of *Raymond*
 (distance) (direction) (nearest town)


WELL PURPOSE: *Home*
 (home, irrigation, municipal, industrial)

WELL COMPLETION DATA:

- (1) diameter (inches) 2"
- (2) total depth (feet) 347'
- (3) static water level (feet) 170' below top of ground.
- (4) casing Steel, 342'
 (material) (depth)
2" if telescope see back.
 (size)
- (5) screen 5', 342'
 (length) (depth to top)
2", Brass
 (size) (material)
- (6) pump 3/4 (Rod) 7
 (HP) (yield gpm)
110V
 (type power)
- (7) electric log No
 (yes or no)
 (organization running log)
- (8) how well bottom plugged 2" B/W
naive

description of formations encountered	from	to
<i>Clay & silt red sand</i>	<i>0</i>	<i>20</i>
<i>Clay</i>		<i>56</i>
<i>bluff clay</i>		<i>61</i>
<i>Clay</i>		<i>82</i>
<i>Silt</i>		<i>94</i>
<i>Clay & Rock</i>		<i>102</i>
<i>Red clay & rock</i>		<i>143</i>
<i>hard shale</i>		<i>184</i>
<i>Shale & silt & sand</i>		<i>201</i>
<i>Fine sand</i>		<i>204</i>
<i>Clay</i>		<i>245</i>
<i>Clay & silt rock</i>		<i>265</i>
<i>Shale</i>		<i>281</i>
<i>Rock</i>		<i>286</i>
<i>Hard Rock & silt shale</i>		<i>328</i>
<i>Shale & silt rock</i>		<i>338</i>
<i>Fine sand & shell</i>		<i>348</i>

CODED

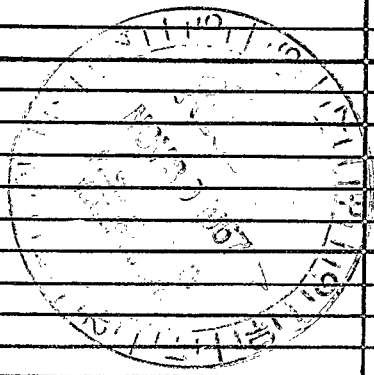

DRILLERS REMARKS:

