

MISSISSIPPI
BOARD OF WATER COMMISSIONERS
416 North State Street
Jackson, Mississippi 39201

CODED

WATER WELL DRILLERS LOG

~~WELLS~~
~~WELLS~~
039
2-1-71
R-1

1971 EB FORE

~~Hubbard~~

date well completed

firm name

county well located

LANDOWNER: MRS
Neomi Allen
 Hwy 27 - Utica Miss
(mailing address)

description of formations encountered

from to

WELL LOCATION:
sec. 11 T 14 N R 5 E
5 miles SW of Hubbard
(distance) (direction) (nearest town)

Brown CO	0	10
Gray Cl	10	20
White Sh, cl	20	30
	30	40
Blue Cla	40	118
Sd Rock 1	118	120
	120	122
cl streak + Sd Rock	122	123
	123	137
White Cl	137	160
Sd - fine	160	170
Soft Sdy cl	170	210
Sd - fine	210	260
Sd - med -	260	275

WELL PURPOSE: HOME
(home, irrigation, municipal, industrial)

- WELL COMPLETION DATA:
- (1) diameter (inches) 4 1/2
 - (2) total depth (feet) 275
 - (3) static water level (feet) 25 below top of ground.
 - (4) casing SALV 270
(material) (depth)
 - (size) if telescope see back.
 - (5) screen 10' 270'
(length) (depth to top)
 - .08 2" S Steel
(size) (material)
 - (6) pump 3/4 10
(HP) (yield gpm)
 - Elee
(type power)
 - (7) electric log No
(yes or no)
 - NONE
(organization running log)
 - (8) how well bottom plugged BLW

CODED


FEB 3 1971

DRILLERS REMARKS:

MISS. BD OF
WATER COMM

If well telescopes please sketch and show depths.

GROUND LEVEL

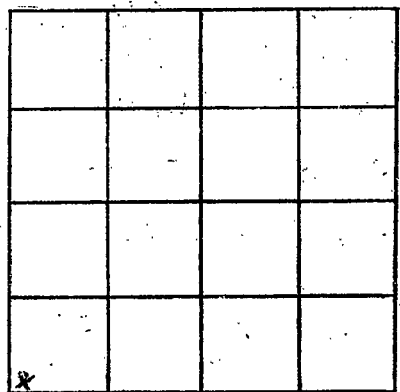

SECTION 11

Please indicate well location X.

ADDITIONAL INFORMATION

A series of horizontal lines for writing additional information.

If more than one screen, show locations of each on sketch.