

Hinds  
 844  
 1-31-72

MISSISSIPPI  
 BOARD OF WATER COMMISSIONERS  
 416 North State Street  
 Jackson, Mississippi 39201

CODED

WATER WELL DRILLERS LOG


1-31-72 date well completed      1972 Forest Drilling Des. firm name      Hinds county well located

LANDOWNER: <u>Charlie Palm</u>	description of formations encountered	from	to
<u>Route 1, Box 267, Edwards, Miss (mailing address)</u>			
<u>WELL LOCATION:</u>	<u>Brown Clay</u>	<u>0</u>	<u>50</u>
sec. <u>1</u> T <u>14</u> N R <u>4</u> E	<u>Blue clay</u>	<u>50</u>	<u>102</u>
<u>2</u> miles <u>N</u> of <u>Learned</u>	<u>Clay</u>	<u>102</u>	<u>156</u>
(distance) (direction) (nearest town)	<u>Rock streaks</u>	<u>156</u>	<u>160</u>
<u>WELL PURPOSE:</u> <u>home</u>	<u>Rock + clay</u>	<u>160</u>	<u>183</u>
(home, irrigation, municipal, industrial)	<u>Clay + Rock</u>	<u>183</u>	<u>204</u>
<u>WELL COMPLETION DATA:</u>	<u>Rock</u>	<u>204</u>	<u>209</u>
(1) diameter (inches) <u>2"</u>	<u>Shale</u>	<u>209</u>	<u>245</u>
(2) total depth (feet) <u>300'</u>	<u>Shale + Silt</u>	<u>245</u>	<u>280</u>
(3) static water level (feet) <u>27</u> below top of ground.	<u>Fine Sand</u>	<u>280</u>	<u>291</u>
(4) casing <u>galv.</u> (material), <u>290</u> (depth)	<u>Fine Sand + Clay</u>	<u>291</u>	<u>307</u>
<u>2"</u> (size) if telescope see back.	<u>Shale</u>	<u>307</u>	<u>327</u>
(5) screen <u>10'</u> (length), <u>300</u> (depth to top)			
<u>2"</u> (size) <u>Slot</u> (material)			
(6) pump <u>3/4</u> (HP), <u>400 GPH</u> (yield gpm)			
<u>Electric</u> (type power)			
(7) electric log <u>No</u> (yes or no)			
(organization running log)			
(8) how well bottom plugged? <u>2" Back</u>			
<u>Wash Valve</u>			
<u>DRILLERS REMARKS:</u>			

CODED

If well telescopes please sketch and show depths.

GROUND LEVEL

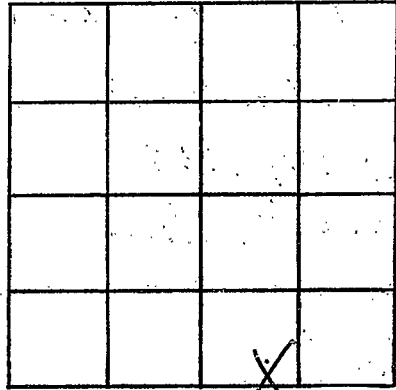

SECTION 1

Please indicate well location X.

ADDITIONAL INFORMATION

If more than one screen, show locations of each on sketch.