

HINDS  
046  
5-27-72

MISSISSIPPI  
BOARD OF WATER COMMISSIONERS  
416 North State Street  
Jackson, Mississippi 39201

CODED

WATER WELL DRILLERS LOG

5/27 1972 Paul D. Higgins Hinds  
date/well completed firm name county well located


LANDOWNER:		description of formations encountered	from	to		
<u>Martine Smith</u> <u>R.H. Edwards Miss</u> (mailing address) <u>3206</u>					<u>Clay + gravel</u>	<u>0</u>
<p><b>WELL LOCATION:</b></p> sec. <u>4</u> T <u>4</u> N R <u>4</u> W E <u>7</u> miles <u>South</u> of <u>Edwards</u> (distance) (direction) (nearest town) <p><b>WELL PURPOSE:</b> <u>Home</u>            (home, irrigation, municipal, industrial)</p> <p><b>WELL COMPLETION DATA:</b></p> (1) diameter (inches) <u>2"</u> (2) total depth (feet) <u>325</u> (3) static water level (feet) <u>30</u> below top of ground. (4) casing <u>Galv.</u> , <u>315</u> (material) (depth) <u>2"</u> (size) if telescope see back. (5) screen <u>2"</u> , <u>315</u> (length) (depth to top) <u>1/2"</u> , <u>55</u> (size) (material) (6) pump <u>2 HP</u> , <u>350</u> (HP) (yield gpm) <u>220</u> , <u>Electric</u> (type power) (7) electric log <u>No</u> (yes or no) (organization running log) (8) how well bottom plugged <u>Valve</u> <p><b>DRILLERS REMARKS:</b></p>		<u>broken clay</u>	<u>20</u>	<u>30</u>		
		<u>fine clay</u>	<u>30</u>	<u>98</u>		
		<u>Clay + rock</u>	<u>98</u>	<u>102</u>		
		<u>Clay</u>	<u>102</u>	<u>136</u>		
		<u>Slt. (sh + lock)</u>	<u>136</u>	<u>142</u>		
		<u>Clay</u>	<u>142</u>	<u>161</u>		
		<u>Rock</u>	<u>161</u>	<u>163</u>		
		<u>Clay</u>	<u>163</u>	<u>177</u>		
		<u>Clay with 7. sand</u>	<u>177</u>	<u>184</u>		
		<u>Clay</u>	<u>184</u>	<u>225</u>		
		<u>Clay + 1/2" rck</u>	<u>225</u>	<u>245</u>		
		<u>Clay</u>	<u>245</u>	<u>256</u>		
		<u>Rock + Clay</u>	<u>256</u>	<u>310</u>		
		<u>fine sand</u>	<u>310</u>	<u>327</u>		

CODED

5-27-72

If well telescopes please sketch and show depths.

GROUND LEVEL

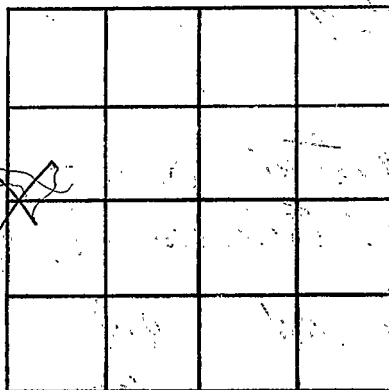

SECTION     *f*    

Please indicate well location X.

ADDITIONAL INFORMATION

If more than one screen, show locations of each on sketch.