

HINDS
 048
 5-9-73

MISSISSIPPI
 BOARD OF WATER COMMISSIONERS
 416 North State Street
 Jackson, Mississippi 39201

CODED

WATER WELL DRILLERS LOG

5/4/73 19 Forest Drilling, Inc. Hinds
 date well completed firm name county well located

LANDOWNER:	description of formations encountered	from	to
James Smith	Brown clay	0	40
RT 1 Box 266	Blue clay	40	132
Edwards Miss	rock + clay	132	190
(mailing address)	muck sand + clay	190	204
	clay	204	253
	fine sand + blue clay	253	263
	clay	263	286
	clay + fine sand	266	286
	shy clay	286	327

WELL LOCATION:
 sec. 1 T. 17 N R. 4 E
 2 4N miles N of Pearl
 (distance) (direction) (nearest town)

WELL PURPOSE: Home
 (home, irrigation, municipal, industrial)

- WELL COMPLETION DATA:
- (1) diameter (inches) 2
 - (2) total depth (feet) 262
 - (3) static water level (feet) 15 below above top of ground.
 - (4) casing galv. 262
 (material) (depth)
 - (size) If telescope see back.
 - (5) screen 10 252
 (length) (depth to top)
 - 2 Stainless
 (size) (material)
 - (6) pump ~~#00~~ 400 gph
 (HP) (yield gpm)
 - Elec.
 (type power)
 - (7) electric log no
 (yes or no)
 - (organization running log)
 - (8) how well bottom plugged B.W. Value


CODED

CLASSIFIED 1973

DRILLERS REMARKS:

If well telescopes please sketch and show depths.

GROUND LEVEL

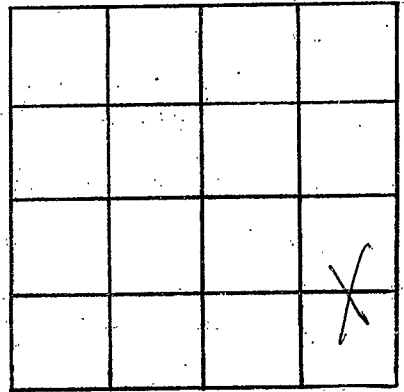

SECTION 1

Please indicate well location X.

ADDITIONAL INFORMATION

Lined area for additional information.

If more than one screen, show locations of each on sketch.