

HINDS
 Ø 50
 3-15-74
 EL# 541

MISSISSIPPI
 BOARD OF WATER COMMISSIONERS CODED
 416 North State Street
 Jackson, Mississippi 39201

WATER WELL DRILLERS LOG

3-15 1974 JACK Guinn Hinds
 date well completed firm name county well located

LANDOWNER:
 Woodward, E
 Ernest on Hwy
 (mailing address)

description of formations encountered	from	to
TOP. SOIL	0	6
CLAY	1	30
SAND	70	96
CLAY	96	165
ROCK	165	203
CLAY	215	270
SAND	270	271


WELL LOCATION:
 sec. 12 T 48 S R 4 E
 1/2 miles N of LEARNED
 (distance) (direction) (nearest town)

WELL PURPOSE:
 (home, irrigation, municipal, industrial)

- WELL COMPLETION DATA:
- (1) diameter (inches) 4"
 - (2) total depth (feet) 291
 - (3) static water level (feet) 41 below top of ground.
 - (4) casing T&C 276 (material) (depth)
 - 4" if telescope see back. (size)
 - (5) screen 15' 276 (length) (depth to top)
 - 2" 45 (size) (material)
 - (6) pump 1 10 (HP) (yield gpm)
 - MPL (type power)
 - (7) electric log yes (yes or no)
 - UNK. (organization running log)
 - (8) how well bottom plugged B.W.U.

CODED

DRILLERS REMARKS: Log RAW
 Never Received

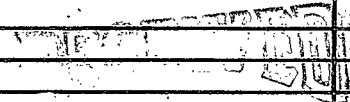

DEC 19 1974

MISS. BD. OF WATER COMMISSIONERS

If well telescopes please sketch and show depths.

GROUND LEVEL

SECTION _____

Please indicate well location X.

ADDITIONAL INFORMATION

If more than one screen, show locations of each on sketch.