

MISSISSIPPI DEPARTMENT OF NATURAL RESOURCES

Bureau of Land and Water Resources

Southport Mall

P.O. Box 10631

Jackson, Mississippi 39209

**CODED**

WATER WELL DRILLERS LOG

HINDS
051
8-23-84

8-23 1984 Jack Guinn Water Wells Hinds  
 date well completed firm name county well located

LANDOWNER:  
 Morningstar Baptist Church  
 (mailing address)

WELL LOCATION:  
 sec. 2 T. 4N N.W. 4 R. 4W E 4  
 SE 4 W  
 7 miles West of Raymond  
 (distance) (direction) (nearest town)

WELL PURPOSE: Church  
 (home, irrigation, municipal, industrial)

WELL COMPLETION DATA:

(1) diameter (inches) 6 1/2

(2) total depth (feet) 219

(3) static water level (feet) 90 below surface  
 top of ground.

(4) casing 4" PVC, 186  
 (material) (depth)  
 (size) If telescope see back.

(5) screen 30 ft., 216  
 (length) (depth to top)  
 (size) (material)

(6) pump 1/2, 7  
 (HP) (yield gpm)  
Electric  
 (type power)

(7) electric log yes  
 (yes or no)  
Bureau Geology  
 (organization running log)

(8) how well bottom plugged good


description of formations encountered	from	to
clay	0	20
clay	20	40
clay	40	60
clay	60	80
clay	80	100
clay	100	120
sand & shale	120	140
sand & shale & rock	140	160
rock & sand	160	180
sand	180	200
sand & clay	200	219

DRILLERS REMARKS:

DEPT. OF NATURAL RESOURCES  
 BUREAU OF LAND & WATER RESOURCES  
 SEP 13 1984  
**RECEIVED**

If well telescopes please sketch and show depths.

GROUND LEVEL

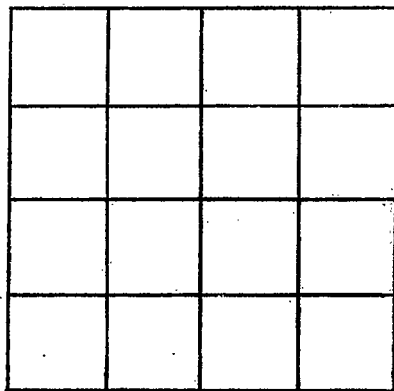

SECTION \_\_\_\_\_

Please indicate well location X.

ADDITIONAL INFORMATION

If more than one screen, show locations of each on sketch.