

Hinds

056

9-28-79

E 66 F 668

9-28

1979

Jack C. Quinn

Hinds

MISSISSIPPI BOARD OF WATER COMMISSIONERS 416 North State Street Jackson, Mississippi 39201

CODED

WATER WELL DRILLERS LOG

date well completed

firm name

county well located

LANDOWNER:

Mr. Fisher

(mailing address)

WELL LOCATION:

sec. 15 (T) 14 (N) R. 5 (E)

4 miles N. Cabanuka (distance) (direction) (nearest town)

WELL PURPOSE: Home (home, irrigation, municipal, industrial)

CODED

WELL COMPLETION DATA:

- (1) diameter (inches) 6 1/2 in.
- (2) total depth (feet) 352 ft.
- (3) static water level (feet) 120 below top of ground.
- (4) casing P.V.C. - 4" 306 ft. (material) (depth)
- 4 in (size) if telescope see back.
- (5) screen 20 ft. 308 (length) (depth to top)
- 4 in (size) P.V.C. (material)
- (6) pump 1 (HP) 10 (yield gpm)
- Electric (type power)
- (7) electric log yes (yes or no)
- M. S. I. (organization running log)
- (8) how well bottom plugged Back was value

description of formations encountered

from to

Top soil	0	20
Clay shell	20	244
Rock	244	308
Sand	308	320
Clay	320	330
Sand	330	352

DRILLERS REMARKS:


DEPT. OF NATURAL RESOURCES BUREAU OF LAND & WATER RESOURCES

DEC 17 1979

RECEIVED

If well telescopes please sketch and show depths.

GROUND LEVEL

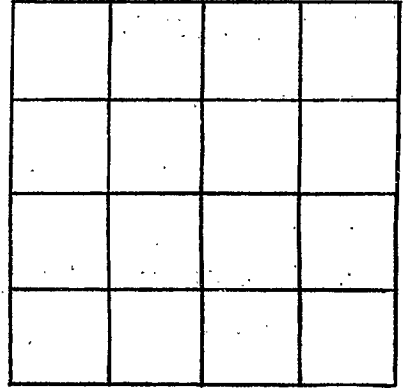

SECTION _____

Please indicate well location X.

ADDITIONAL INFORMATION

If more than one screen, show locations of each on sketch.