

Hinds

D-57

12-21-79

12-21, 1979 Griner Drilling Hinds

date well completed

firm name

county well located

MISSISSIPPI BOARD OF WATER COMMISSIONERS 416 North State Street Jackson, Mississippi 39201

WATER WELL DRILLERS LOG

LANDOWNER:

American Quasar Petroleum 1326 Capital Towers Jackson, MS. (mailing address)

description of formations encountered

from to

chalk + rocks 0 394
chalk 394 924
streaked 924 966
sand 966 1000
chalk 1000 1126
chalk 1126 1113
sand 1113 1134
streaked 1134 1367

WELL LOCATION: 1500'S + 1825' W

sec 24 T 4 N R 4 E of NE/4 of North of Utica (distance) (direction) (nearest town)

WELL PURPOSE: oil field supply (home, irrigation, municipal, industrial)

WELL COMPLETION DATA:

- (1) diameter (inches) 3"
(2) total depth (feet) 1367'
(3) static water level (feet) 180' below top of ground.
(4) casing steel, 1160' (material) (depth) 3" (size) if telescope see back.
(5) screen 42' 1118' (length) (depth to top) 3" perforated (size) (material)
(6) pump 85 (HP) (yield gpm) AC (type power)
(7) electric log yes (yes or no) Schlumberger (organization running log)
(8) how well bottom plugged orange peel

DRILLERS REMARKS:


DEPT. OF NATURAL RESOURCES BUREAU OF LAND & WATER

JAN 9 1980

RECEIVED

If well telescopes please sketch and show depths.

GROUND LEVEL

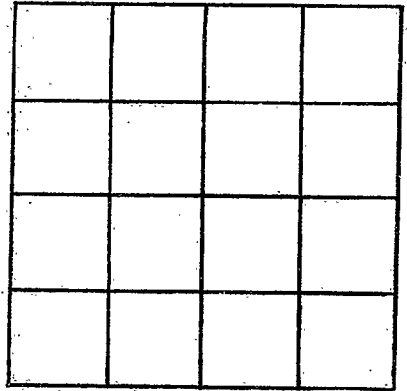

SECTION \_\_\_\_\_

Please indicate well location X.

ADDITIONAL INFORMATION

If more than one screen,  
show locations of each on sketch.