

Hinds

MISSISSIPPI
BOARD OF WATER COMMISSIONERS
416 North State Street
Jackson, Mississippi 39201

CODED

WATER WELL DRILLERS LOG

0-58
 E Log # 677
 4/10/80
 4/16/80

Jack Quinn

Hinds

date well completed 19 firm name county well located

LANDOWNER:
 Eunice Driffin
 Edwards, Ms.
 (mailing address)

WELL LOCATION:
 sec. 12 T. 4 N. R. 4 E. S. W.

(distance) miles (direction) of (nearest town)

WELL PURPOSE: home
 (home, irrigation, municipal, industrial)

description of formations encountered	from	to
Sandy	0	15
Sandy shale	15	100
Shale	100	130
Sand	130	150
lime rock	150	200
Sand w/shale	200	220
Shale	220	240
Sand w/ shale str	240	285
Shale	285	287

WELL COMPLETION DATA:

(1) diameter (inches) 4"

(2) total depth (feet) 287

(3) static water level (feet) 90 below top of ground.

(4) casing PVC 240' (material) (depth)

(size) If telescope see back.

(5) screen 40 240' (length) (depth to top)
 4" PVC Sch #4 (C.012) (size) (material)

(6) pump 1 (Sub) (HP) (yield gpm)

elec. (type power)

(7) electric log yes (yes or no)
 Ms. Geo Sarvey (organization running log)

(8) how well bottom plugged

CODED

DEPT. OF NATURAL RESOURCES
BUREAU OF LAND & WATER RESOURCES


AUG 19 1980

RECEIVED

DRILLERS REMARKS:

If well telescopes please sketch and show depths.

GROUND LEVEL

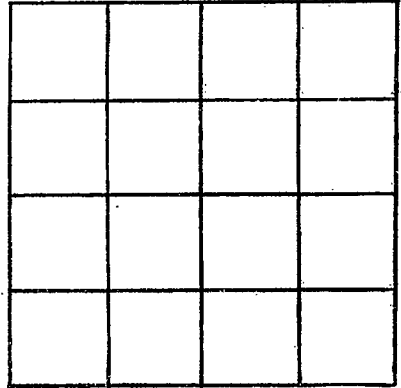

SECTION _____

Please indicate well location X.

ADDITIONAL INFORMATION

If more than one screen, show locations of each on sketch.