

MISSISSIPPI DEPARTMENT OF NATURAL RESOURCES

Bureau of Land and Water Resources

Southport Mall

P.O. Box 10631

Jackson, Mississippi 39209

WATER WELL DRILLERS LOG

CODED

Griner Drilling Service, Inc.

Hinds

Old
HINDS
5-6-84

5-6-84 date well completed

Griner Drilling Service, Inc. firm name

Hinds county well located

LANDOWNER:

Quarles Drilling
1503 Engineer Road
Belle Chase, La. 70037

description of formations encountered

from

to

(mailing address)

clay, rocks

0 126

streaked sand

126 168

WELL LOCATION: 1900'S & 2008'E

sec. 3 T. 14 N. R. 5 E New Orleans

sand

168 210

NO. 1-3
Newman Field
Newman Field
1.3 miles (distance) N (direction) of (nearest town)

streaks of sand

210 252

sand

252 278

WELL PURPOSE: oilfield supply
(home, irrigation, municipal, industrial)

clay

278 294

WELL COMPLETION DATA:

- (1) diameter (inches) 4"
- (2) total depth (feet) 294'
- (3) static water level (feet) 70' ^{below} _{above} top of ground.
- (4) casing steel, 294'
(material) (depth)
4"
(size) if telescope see back.
- (5) screen 20', 274'
(length) (depth to top)
4", stainless steel
(size) (material)
- (6) pump 5HP 70
(HP) (yield gpm)
480 volt 3 phase
(type power)
- (7) electric log NO
(yes or no)

(organization running log)

- (8) how well bottom plugged, 4"
backwash valve

DRILLERS REMARKS:


DEPT. OF NATURAL RESOURCES
BUREAU OF LAND & WATER RESOURCES

MAY 21 1984

RECEIVED

If well telescopes please sketch and show depths.

GROUND LEVEL

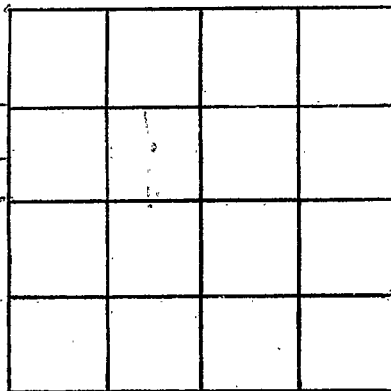

SECTION _____

Please indicate well location X.

ADDITIONAL INFORMATION

If more than one screen, show locations of each on sketch.