

MISSISSIPPI DEPARTMENT OF NATURAL RESOURCES

Bureau of Land and Water Resources

Southport Mall

P.O. Box 10631

Jackson, Mississippi 39209

WATER WELL DRILLERS LOG

CODED

HINDS
 067
 1-30-85

Griner Drilling
 Service, INC

Hinds

1-30-85 date well completed

Griner Drilling Service, INC firm name

Hinds county well located


LANDOWNER:	description of formations encountered	from	to
Quarles Drilling 1503 Engineer Road Belle Chase, La. 70031 (mailing address)	sand, clay	0	21
	rock & clay	21	80
WELL LOCATION: 500'S & 950' W of sec. 4 T. 14N R. 5E NE 1/4	sand	80	115
No. 1-4 Laura Newman Field Laura Newman (direction) of Newman (nearest town)	rock, clay, sand breaks	115	155
WELL PURPOSE: oilfield supply (home, irrigation, municipal, industrial)	sand	155	236
WELL COMPLETION DATA:	clay	236	252
(1) diameter (inches) 4"			
(2) total depth (feet) 252'			
(3) static water level (feet) 20' below top of ground			
(4) casing steel 210' (material) (depth) 4" (size) if telescope see back.			
(5) screen 20' 190' (length) (depth to top) 4" stainless steel (size) screen			
(6) pump 5 HP 70 (yield gpm) 480 volt 3 phase (type power)			
(7) electric log (yes or no)			
(organization running log)			
(8) how well bottom plugged 4" back wash valve			
DRILLERS REMARKS:			

RECEIVED
 FEB 25 1985

Department of Natural Resources
 Bureau of Land & Water Resources

If well telescopes please sketch and show depths.

GROUND LEVEL

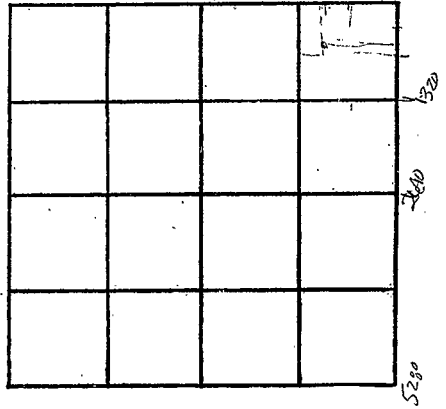

SECTION _____

Please indicate well location X.

ADDITIONAL INFORMATION

If more than one screen,
show locations of each on sketch.