

MISSISSIPPI DEPARTMENT OF NATURAL RESOURCES

Bureau of Land and Water Resources

Southport Mall

P.O. Box 10631

Jackson, Mississippi 39209

WATER WELL DRILLERS LOG

CODED

HINDS
 69

6 27 19 85 STEVE GARDNER WATER WELLS HINDS
 date well completed firm name county well located

LANDOWNER:	description of formations encountered	from	to
BUSTY EMERICK	CLAY	0	56
(mailing address)			
WELL LOCATION: sec. 3 T. 14 N R. 5 E S W 9 miles N of VITICA (distance) (direction) (nearest town)	CLAY, LIMESTONE ROCK, SAND	50	130
WELL PURPOSE: HOME (home, irrigation, municipal, industrial)	CLAY, LIMESTONE SAND	130	170
WELL COMPLETION DATA:	SAND	170	280
(1) diameter (inches) 4			
(2) total depth (feet) 280			
(3) static water level (feet) 20 below top of ground.			
(4) casing PVC 200 (material) (depth)			
(size) if telescope see back.			
(5) screen 40 240-200 (length) (depth to top)			
4 PVC (size) (material)			
(6) pump 3/4 10 (HP) (yield gpm)			
AC (type power)			
(7) electric log YES (yes or no)			
BUREAU GEOLOGY (organization running log)			
(8) how well bottom plugged BACK WASH VAL.			

DRILLERS REMARKS:
 TEA WATER.

CODED

THIS WELL
 WILL GIVE UP
 50 TO 60
 G.P.M.


RECEIVED

FEB 10 1987

Department of Natural Resources
 Bureau of Land & Water Resources

If well telescopes please sketch and show depths.

GROUND LEVEL

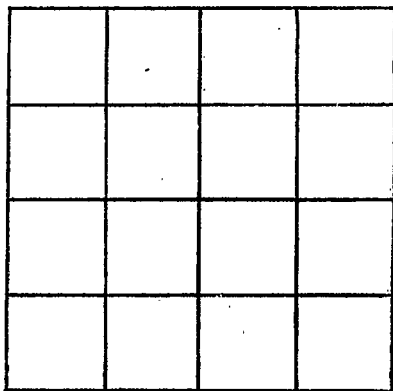

SECTION _____

Please indicate well location X.

ADDITIONAL INFORMATION

If more than one screen, show locations of each on sketch.