

0201
2-25-65

WATER WELL DRILLERS LOG

32-10-58
90-38-56

Date: 2-25, 1965, Driller: ELLIS C HALL County HINDS
HALL DRILLING CO

- (1) Owner of Land: FRED YATES JR
(Name)
RT-2 UTICA MISS
(Address)
- (2) Location: E 1/4, SW 1/4, Sec. 18 TAMMAY
5 miles N.W. of UTICA
(distance) (direction) (Nearest Town)
- (3) Topography: HILLY
(Hilly) (Flat) (Level)
- (4) Purpose of Well: DOMESTIC HOME
(Domestic Irrigation
Municipal, Industrial, Other)

Description & Color of Materials Sand, Clay, Red Clay, Shell, etc.	Thick- ness Feet	Depth Feet
<u>SURFACE SOIL</u>	<u>6</u>	<u>6</u>
<u>GREY MARL</u>	<u>35</u>	<u>41</u>
<u>BLUE SHALE</u>	<u>20</u>	<u>61</u>
<u>ROCK + SHALE</u>	<u>106</u>	<u>167</u>
<u>BROWN SHALE</u>	<u>67</u>	<u>234</u>
<u>ROCK HARD</u>	<u>61</u>	<u>295</u>
<u>SAND + SEA SHELL</u>	<u>15</u>	<u>310</u>
<u>SAND (FINE)</u>	<u>29</u>	<u>339</u>
<u>SAND + LIGNITE</u>	<u>61</u>	<u>400</u>
<u>SAND (FINE)</u>	<u>20</u>	<u>420</u>
<u>SAND + LIGNITE</u>		
<u>W/SEA SHELL</u>	<u>41</u>	<u>461</u>


Information upon completion of well:

- (1) Diameter 4 X 2 inches.
- (2) Total Depth 461 feet.
- (3) Water Level 80 feet below top of ground.
- (4) Cased to 220'44", Size 4
221 2
- (5) Screen: Size 2, Length 20
- (6) Were any formations sealed against pollution?
_____ yes, X no.

If YES depth of formation _____

Why _____

Drillers Remarks: _____

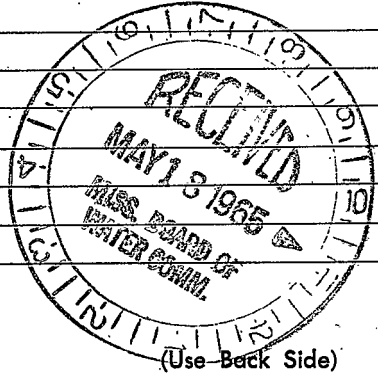

Well No. 8