

HINDS
 O 2003
 4-68

MISSISSIPPI
 BOARD OF WATER COMMISSIONERS
 416 North State Street
 Jackson, Mississippi 39201

WATER WELL DRILLERS LOG

4-23 1968 Joint Drilling Co Hinds
 date well completed firm name county well located

LANDOWNER: Connie Moore
 Rt 1
 Edwards Mrs
 (mailing address)

description of formations encountered	from	to
Clay	0	20
Gravel		22
Clay		102
Shale + Sths Rock		122
Sandy Shell		132
Rock		135
Shale		140
Rock		146
Rock + Sths Shale		184
Fine Sand		195
Shale + Sths + Shell		204
Shell + Sths + Sand		245
Fine Sand		254

WELL LOCATION:
 sec 2 T 4 N R 4 W
 S E
 1 1/2 miles west of Hatching
 (distance) (direction) (nearest town) Grace

WELL PURPOSE: Home
 (home, irrigation, municipal, industrial)

WELL COMPLETION DATA:


- (1) diameter (inches) 2"
- (2) total depth (feet) 254'
- (3) static water level (feet) 25 below top of ground.
- (4) casing Galv 249' (material) (depth)
 2" (size) if telescope see back.
- (5) screen 5 ft 249' (length) (depth to top)
 2" Stainless Steel (size) (material)
- (6) pump 3/4 HP 450 GPH (HP) (yield gpm)
 Elect 7570 (type power)
- (7) electric log No- (yes or no)
- (organization running log)
- (8) how well bottom plugged Backwash valve

DRILLERS REMARKS:

MAY 16 1968
 MISS. Bd. of
 WATER COMMISSIONERS

If well telescopes please sketch and show depths.

GROUND LEVEL

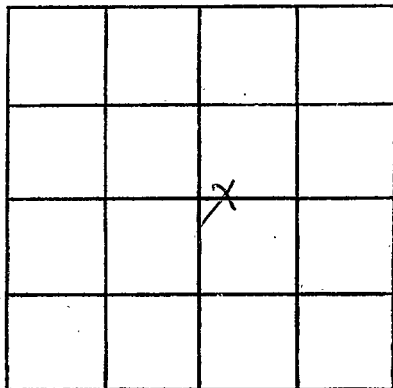

SECTION 2

Please indicate well location X.

ADDITIONAL INFORMATION

If more than one screen, show locations of each on sketch.