

Heads  
 O 2006

MISSISSIPPI  
 BOARD OF WATER COMMISSIONERS  
 416 North State Street  
 Jackson, Mississippi 39201

WATER WELL DRILLERS LOG

9-14 1983 date well completed  
 B Quinn Well Services firm name  
 Heads county well located

LANDOWNER:  
 Jim Tisdale  
 (mailing address)

description of formations encountered	from	to
	CLAY SAND	0 210

WELL LOCATION:  
 sec. 25 T 4 N R 4 E  
 S W  
 miles of (distance) (direction) (nearest town)

WELL PURPOSE:  
 (home, irrigation, municipal, industrial)

WELL COMPLETION DATA:

(1) diameter (inches) 44

(2) total depth (feet) 220

(3) static water level (feet) 17 below top of ground.

(4) casing PVC 210 (material) (depth)  
 4 (size) if telescope see back.

(5) screen 15' 210 (length) (depth to top)  
 4" PVC (size) (material)

(6) pump 3/4 10 (HP) (yield gpm)  
 (type power)

(7) electric log (yes or no)

(organization running log)

(8) how well bottom plugged Bally

DEPT. OF NATURAL RESOURCES  
 BUREAU OF LAND & WATER RESOURCES


DRILLERS REMARKS:

NOV - 9 1983

RECEIVED

If well telescopes please sketch and show depths.

GROUND LEVEL

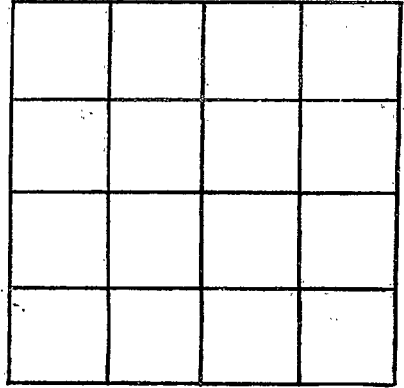

SECTION \_\_\_\_\_

Please indicate well location X.

ADDITIONAL INFORMATION

If more than one screen,  
show locations of each on sketch.