

Hinds
 O 2007
 5-67

MISSISSIPPI
 BOARD OF WATER COMMISSIONERS
 416 North State Street
 Jackson, Mississippi 39201

WATER WELL DRILLERS LOG

5-17 1967 Forest Drilling Hinds
 date well completed firm name county well located


LANDOWNER: Lucene Turner
Rt 1 - Box 237
Edwards, Miss.
 (mailing address)

WELL LOCATION:
 sec. 2 T. 4 N. R. 4 W.
1/2 miles west of Morning Star
 (distance) (direction) (nearest town)

WELL PURPOSE: Home
 (home, irrigation, municipal, industrial)

- WELL COMPLETION DATA:
- (1) diameter (inches) 2"
 - (2) total depth (feet) 278'
 - (3) static water level (feet) 49 below above top of ground.
 - (4) casing Galv. 2 3/4" (material) (depth)
 - 2" (size) if telescope see back.
 - (5) screen 5 ft (length) (depth to top)
2" (size) Johnson's (material)
 - (6) pump _____ (HP) _____ (yield gpm)
 _____ (type power)
 - (7) electric log no (yes or no)
 _____ (organization running log)
 - (8) how well bottom plugged Backwash
value


| description of formations encountered | from | to |
|---------------------------------------|------|-----|
| Brown Clay | 0 | 58 |
| Blue Clay | | 61 |
| Clay + fine sand | | 102 |
| Clay | | 143 |
| Clay + silt rock | | 164 |
| Clay | | 170 |
| Rock | | 174 |
| Clay | | 178 |
| Rock | | 184 |
| Rock + silt clay | | 194 |
| Argill. Shell. | | 230 |
| Clay | | 259 |
| Fine sand + silt clay | | 265 |
| Fine sand | | 278 |

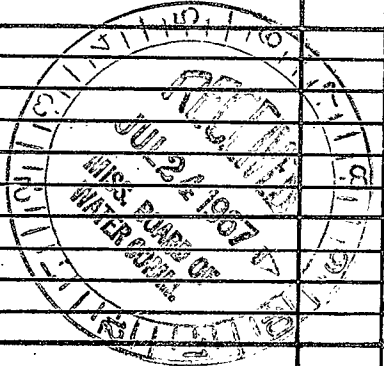

DRILLERS REMARKS:

If well telescopes please sketch and show depths.

GROUND LEVEL

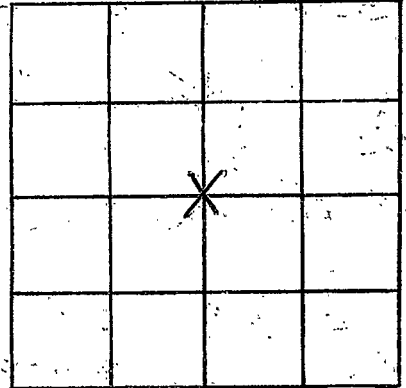

SECTION 2

Please indicate well location X.

ADDITIONAL INFORMATION

If more than one screen, show locations of each on sketch.