

HINDS

MISSISSIPPI BOARD OF WATER COMMISSIONERS

~~P 2~~

P 300

8-19-61

WATER WELL DRILLERS LOG

Date: August 19 1961, Driller: W. G. Butler

County: Hinds Smith

(Name)

| (1) Owner of Land: <u>J. Madge Brock</u> | Description & Color of Materials Sand, Clay, Red Clay, Shell, etc. | Thick- ness Feet | Depth Feet |
|--|---|------------------------|---------------|
| (Name) | Clay | 1- | 2 |
| <u>Raymond Miss.</u> | Chalk | 2- | 30 |
| (Address) | Sand + shale | 30- | 40 |
| (2) Location: <u>NW SE 1/4, SW 1/4, Sec. 1 T4R3S</u> | Rock + shale | 40- | 90 |
| N W | Shell (fine) | 90- | 100 |
| _____ miles _____, of _____ | Gray Chalk | 100- | 110 |
| (distance) (direction) (Nearest Town) | Rock | 110- | 120 |
| (3) Topography: _____ | Gumbo | 120- | 130 |
| (Hilly) (Flat) (Level) | Chalk | 130- | 140 |
| (4) Purpose of Well: <u>Domestic Home</u> | shale | 140- | 160 |
| (Domestic Irrigation Municipal, Industrial, Other) | Sand | 160- | 188 |


Information upon completion of well:

- (1) Diameter 2 inches.
- (2) Total Depth _____ feet.
- (3) Water Level _____ feet below top of ground.
- (4) Cased to _____, Size _____.
- (5) Screen: Size _____, Length _____.
- (6) Were any formations sealed against pollution?
_____ yes, _____ no.

If YES depth of formation _____

Why _____

Drillers Remarks: _____

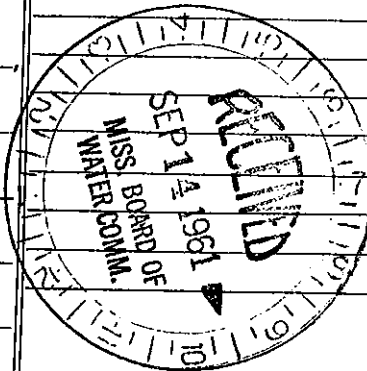

(Use Back Side)

Well No.

Mail this copy to Board of Water Commissioners 429 Miss. St. Jackson, Miss