

HINDS
P

MISSISSIPPI BOARD OF WATER COMMISSIONERS


11-61

WATER WELL DRILLERS LOG

Q-300

Date: NOV. 1961, Driller: MCNEECE DRILLING Co. HINDS
(Name Co.)

(1) Owner of Land: MRS A.B. CHAPMAN (Name)	Description & Color of Materials Sand, Clay, Red Clay, Shell, etc.	Thick- ness Feet	Depth Feet
RT. 1, RAYMOND MISS. (Address)	RED SAND	45	0
NW 1/4 of NE 1/4 + N 1/2 of SE 1/4 + NW 1/4 and (2) Location: NE 1/4, NW 1/4, Sec. 11 T4R2W	WHITE SAND SHALE	74 12	45 119
6 miles S.W. of RAYMOND (distance) (direction) (Nearest Town)	SHALE + SAND BLACK SHALE	61 148	131 192
(3) Topography: Hilly (Hilly) (Flat) (Level)	ROCK LEDGES SHALE, SHELL + SAND	40 20	340 380
(4) Purpose of Well: DOMESTIC (Domestic Irrigation Municipal, Industrial, Other)	SHALE FINE SAND	43 20	400 443
Information upon completion of well:	SHALE FINE SAND	20 24	463 483
(1) Diameter 4 1/2" inches.	SAND	13	507 520
(2) Total Depth 520 feet.			
(3) Water Level 176 feet below top of ground.			
(4) Cased to 258', Size 4" 258'-520' / 2"			
(5) Screen: Size 2", Length 10'			
(6) Were any formations sealed against pollution? yes, <input checked="" type="checkbox"/> no.			
If YES depth of formation _____			
Why _____			
Drillers Remarks: _____			

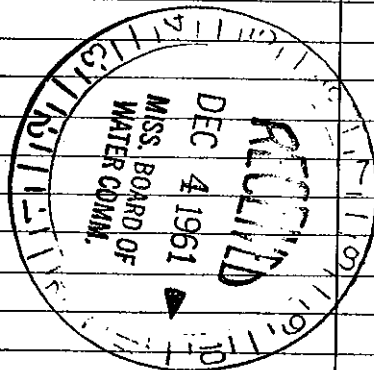

Well No
250

(Use Back Side)

Mail this copy to Board of Water Commissioners 429 Miss. St. Jackson, Miss