

HINDS
P-47
5-62

MISSISSIPPI BOARD OF WATER COMMISSIONERS

WATER WELL DRILLERS LOG

File # 141

Date: MAY, 1962, Driller: MCNEECE DRILLING Co County HINDS

(Name)

(1) Owner of Land: TOWN OF LEARNED
(Name)
LEARNED MISS.
(Address)

(2) Location: 1/4, 1/4, Sec. 7 14N 3W
(distance) (direction) (Nearest Town)

(3) Topography: FLAT
(Hilly) (Flat) (Level)

(4) Purpose of Well: MUNICIPAL
(Domestic Irrigation
Municipal, Industrial, Other)

Description & Color of Materials Sand, Clay, Red Clay, Shell, etc.	Thick- ness Feet	Depth Feet
SURFACE SOIL	12	12
WHITE SHALE	23	35
GREY SHALE & ROCK	30	65
BLACK SHALE & SAND	42	108
WHITE SAND	12	120
SHALE & LIGNITE	9	129
SHALE & FINE SAND	10	139
SHALE & ROCK	11	150
SHALE	15	165
ROCK LEDGES	50	215
SHALE & SAND	20	235
FINE SAND	10	245
SHALE & SAND	12	257
SAND	8	265
SHALE & SAND	13	278
FINE SAND	4	282
SHALE & LIGNITE	18	300
SHALE & SAND	20	320
SHALE	49	369
MOODY'S BRANCH	28	397
SHALE	16	413
SHALE & SAND	28	441
SHALE & LIGNITE	6	447
SHALE, SAND & LIGNITE	116	563
FINE SAND	90	653
ROCK	6	659
ROCK	50	709

Information upon completion of well:

(1) Diameter 4x2 1/2 inches.

(2) Total Depth 1150 feet.

(3) Water Level 70 feet below top of ground.


(4) Cased to 425', Size 4"
425'-1150' - 2 1/2"

(5) Screen: Size 2 1/2", Length 30'

(6) Were any formations sealed against pollution?
no

If YES depth of formation _____
Why _____

Drillers Remarks: **CODED**

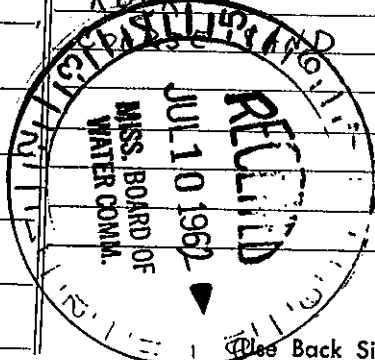

Well No. 31

Mail this copy to Board of Water Commissioners 429 Miss. St. Jackson, Miss.