

HINDS

MISSISSIPPI BOARD OF WATER COMMISSIONERS

Elect Log Well No P51 HINDS CO
WATER WELL DRILLERS LOG CODED 5

Date: 2-15-64, 1964, Driller: James McNeess County HINDS


Log # 189

(Name)

(1) Owner of Land	Description & Color of Materials Sand, Clay, Red Clay, Shell, etc.	Thick- ness Feet	Depth Feet
R.E. Douglas (Name)	clay	20	20
Clinton miss (Address)	Blue shale	20	40
(2) Location: SE 1/4, NE 1/4, Sec 13 T ⁴ N R ³ W	Gray shale	20	60
4 miles south of Raymond (distance) (direction) (Nearest Town)	Blue shale	60	120
(3) Topography: <input checked="" type="checkbox"/> (Hilly) <input type="checkbox"/> (Flat) <input type="checkbox"/> (Level)	Grey sh-sd strks - pine SEND	40	160
(4) Purpose of Well: Domestic (Domestic Irrigation, Municipal, Industrial, Other)	Grey sd shale	117	277
	Lime-sd strks	5	282
	Grey shale	46	328
	Lignite	32	360
	Grey shale	21	381
	Grey shale	56	437

Information upon completion of well:

(1) Diameter 2 1/2 x 2 inches	8 JOINTS 2 1/2"	168	
(2) Total Depth 437 feet	1-2 1/2" x 2" SWEDGE	8	
(3) Water Level 93 feet below top of ground	4 JOINTS 2"	84	4
(4) Cased to 253' Size 2 1/2" x 2"	2-2" 10' sd screens	20	
(5) Screen: Size 2" 208 Length 20	1-2" 7' 1/2" pipe AND B.P.V	273	
(6) Were any formations sealed against pollution? yes <input checked="" type="checkbox"/> no <input type="checkbox"/>		6	
If YES, depth of formation		279	
Why			
Drillers Remarks:			

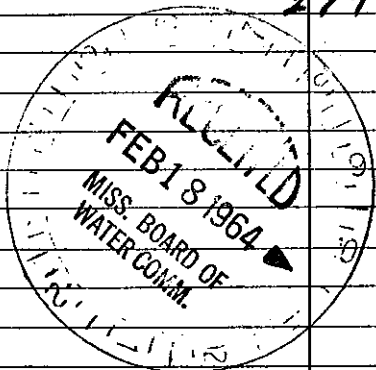

(Use Back Side)

Well No.

Mail this copy to Board of Water Commissioners 429 Miss. St. Jackson, Miss.