

Hinds  
P 58  
8-66

MISSISSIPPI BOARD OF WATER COMMISSIONERS

WATER WELL DRILLERS LOG

CODED

Date: 8-9-, 1966, Driller: HALL DRILLING CO County HINDS  
(Name)

(1) Owner of Land: <u>G. A. ALEXANDER</u> (Name)	Description & Color of Materials Sand, Clay, Red Clay, Shell, etc.	Thick- ness Feet	Depth Feet
<u>RF1-Box 33A RAYMOND MISS</u> (Address)	<u>SURFACE SOIL</u>	<u>3</u>	<u>3</u>
(2) Location: <u>NE 1/4, SW 1/4, Sec. 3 T4N R3W</u>	<u>GREY MARL</u>	<u>39</u>	<u>42</u>
<u>7</u> miles <u>SOUTH WEST</u> of <u>RAYMOND</u> , (distance) (direction) (Nearest Town)	<u>HARD BROWN SHALE</u>	<u>21</u>	<u>63</u>
(3) Topography: <u>FLAT</u> (Hilly) (Flat) (Level)	<u>WHITE SAND</u>	<u>19</u>	<u>82</u>
(4) Purpose of Well: <u>DOMESTIC</u> (Domestic Irrigation Municipal, Industrial, Other)	<u>BLACK SHALE</u>	<u>45</u>	<u>127</u>
	<u>ROCK LEDGES</u>	<u>50</u>	<u>177</u>
	<u>SAND SEA SHAL</u>	<u>8</u>	<u>185</u>
	<u>HARD SHALE</u>	<u>30</u>	<u>215</u>
	<u>SAND W/STREAKS SHALE</u>	<u>32</u>	<u>247</u>
	<u>SHALE</u>	<u>5</u>	<u>252</u>


Information upon completion of well:

- (1) Diameter 4 X 2 inches.
- (2) Total Depth 252 feet.
- (3) Water Level 30 feet below top of ground.
- (4) Cased to 252, Size 200'-4"  
30'-2".
- (5) Screen: Size 2, Length 20.
- (6) Were any formations sealed against pollution?  
no.

If YES depth of formation \_\_\_\_\_

Why \_\_\_\_\_

Drillers Remarks: \_\_\_\_\_

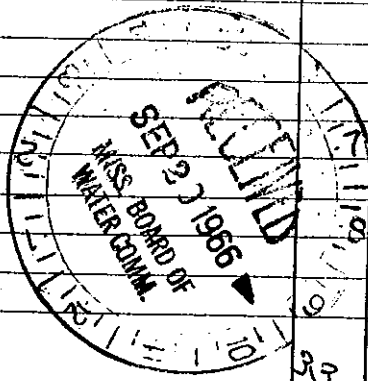

Well No. 33

(Use Back Side)

Mail this copy to Board of Water Commissioners 429 Miss. St. Jackson, Miss