

HINDS
 P 2000
 3-6-61

MISSISSIPPI BOARD OF WATER COMMISSIONERS

WATER WELL DRILLERS LOG


Date: Mar. 6, 19 61, Driller: Burney Water Well Serv County Hinds
 (Ben Burney & Son)

(1) Owner of Land: J. A. Dodson
 (Name)
Utica, Miss.
 (Address)
 Highway 18
 (2) Location: $\frac{1}{4}$, $\frac{1}{4}$, Sec. T10R3W
7 miles East of Utica
 (distance) (direction) (Nearest Town)
 (3) Topography: Hilly
 (Hilly) (Flat) (Level)
 (4) Purpose of Well: Domestic Home
 (Domestic Irrigation
 Municipal, Industrial, Other)

Description & Color of Materials Sand, Clay, Red Clay, Shell, etc.	Thick- ness Feet	Depth Feet
Topsoil	19	19
Rock	2	21
Grey clay	13	34
Limestone	5	39
Sand	6	45
Black marl	5	50
Rock	11	61
Hard blue clay	29	90
Layers of soft formation	14	104
Layers soft & hard "	29	133
Layers rock	7	140
Black & blue formation	22	162
Layers sand	5	167
Hard black shale	22	189
Layers soft & hard black	26	215
Sand	28	243

Information upon completion of well:

(1) Diameter 4 inches.
 (2) Total Depth 249 feet.
 (3) Water Level 64 feet below top of ground.
 (4) Cased to 239, Size 2"
 (5) Screen: Size 2", Length 10'
 (6) Were any formations sealed against pollution?
X yes, no.
 If YES depth of formation From surface
 Why To prevent surface pollution
 Drillers Remarks:

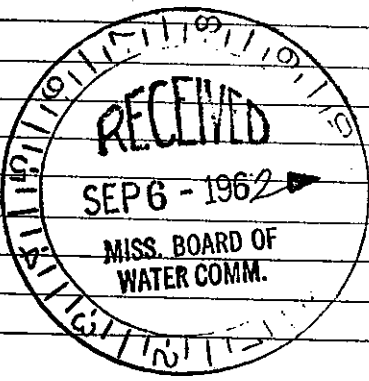

Well No.

(Use Back Side)

Mail this copy to Board of Water Commissioners 429 Miss. St. Jackson, Miss.