


HINDS
P 2001
4-18-61

MISSISSIPPI BOARD OF WATER COMMISSIONERS

WATER WELL DRILLERS LOG

Date: Apr. 18, 1961, Driller: Burney Water Well Serv County Hinds
(Ben Burney & Son)

(1) Owner of Land: <u>Fred Duncan</u> (Name)	Description & Color of Materials Sand, Clay, Red Clay, Shell, etc.	Thick- ness Feet	Depth Feet
<u>Raymond, Miss.</u> (Address)	Topsoil & white clay	12	12
(2) Location: <u>1/4</u> , <u>1/4</u> , Sec. <u>T11R34</u>	Limestone & clay	29	41
<u>3</u> miles <u>South</u> , of <u>Learned</u> , (distance) (direction) (Nearest Town)	Blue clay	9	50
(3) Topography: <u>Hilly</u> (Hilly) (Flat) (Level)	Sand streaks	10	60
(4) Purpose of Well: <u>Domestic Home</u> (Domestic Irrigation Municipal, Industrial, Other)	Layers rock & sand	140	300
	Tight clay	66	366
	Layers sand	6	372
	Tight clay	11	383
	Fine sand	11	394
	Tight clay	30	424
	Clay & sand formation	79	503
Information upon completion of well:			
(1) Diameter <u>4</u> inches.			
(2) Total Depth <u>503</u> feet.			
(3) Water Level <u>96</u> feet below top of ground.			
(4) Cased to <u>252'</u> , Size <u>2"</u>			
(5) Screen: Size <u>2"</u> , Length <u>15'</u>			
(6) Were any formations sealed against pollution? <u>X</u> yes, <u>no.</u>			
If YES depth of formation <u>From Surface</u>			
Why <u>To prevent surface pollution</u>			
Drillers Remarks:			

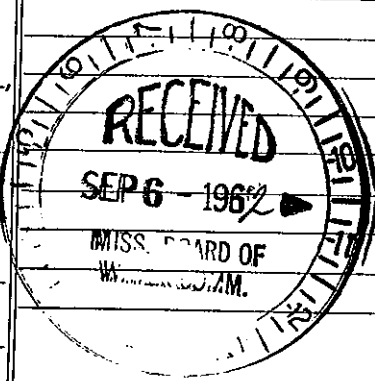

(Use Back Side)

Well No.

Mail this copy to Board of Water Commissioners 429 Miss. St. Jackson, Miss.