

HINDS MISSISSIPPI BOARD OF WATER COMMISSIONERS


P 2007
5-28-64

WATER WELL DRILLERS LOG

Date: 5-28-1964, Drillers: James McNeess County: Hinds

(Name)

(1) Owner of Land		Description & Color of Materials Sand, Clay, Red Clay, Shell, etc.	Thick- ness Feet	Depth Feet
Alden McNeess (Name)		SURFACE 3011	28	28
Lezard Miss (Address)		CLAY	20	53
(2) Location: $\frac{1}{4}$, $\frac{1}{4}$, Sec. <u>T4R36</u>		SAND	10	63
<u>8</u> miles <u>SW</u> of <u>Ryzard</u>		SAND sh STKS	10	73
(distance) (direction) (Nearest Town)		Grey shale	30	103
(3) Topography: <input checked="" type="checkbox"/> (Hilly) <input type="checkbox"/> (Flat) <input type="checkbox"/> (Level)		Grey sh sd STKS	20	123
(4) Purpose of Well: <u>Domestic Home</u>		Grey shale	103	226
(Domestic Irrigation Municipal, Industrial, Other)		SAND	16	242
Information upon completion of well:		10 lbs 2 1/2	213	1
(1) Diameter: <u>2 1/2 x 2 1/2</u> inches.		1-2 1/2 x 2" SWEGE		8
(2) Total Depth: <u>242</u> feet.		1 1/2" 2"	13	10
(3) Water Level: <u>137</u> feet below top of ground.		1-2" .007 SS SCREEN	227	7
(4) Cased to: <u>227</u> feet, Size: <u>2 1/2 x 2</u>		1-2" NIPPLE & BPV	10	237
(5) Screen: Size: <u>2" .007</u> , Length: <u>10</u>			1	238
(6) Were any formations sealed against pollution?			239	2
<input type="checkbox"/> yes, <input type="checkbox"/> no.				
If YES depth of formation _____				
Why _____				
Drillers Remarks: _____				

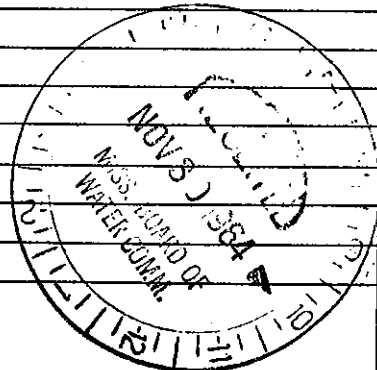

(Use Back Side)

Well No.

Mail this copy to Board of Water Commissioners 429 Miss. St. Jackson, Miss 1