

HINDS MISSISSIPPI BOARD OF WATER COMMISSIONERS

P2009
8-1-64

WATER WELL DRILLERS LOG

Date: Aug 1, 1964, Driller: W. H. Butler County Smith

(Name)

(1) Owner of Land: Dr. Gatewood
(Name)
Raymond Miss
(Address)

(2) Location: 1/4, 1/4, Sec. 12
(distance) (direction) of Raymond
(Nearest Town)

(3) Topography: (Hilly) (Flat) (Level)

(4) Purpose of Well: Domestic Home
(Domestic Irrigation, Municipal, Industrial, Other)

Description & Color of Materials
Sand, Clay, Red Clay, Shell, etc.

Thick-
ness
Feet

Depth
Feet

Chalk	1-10	
Sand + Chalk	10-20	
Brown Chalk	20-30	
Chalk + Rock	30-80	
Chalk (Blue)	80-90	
Blue shale + Rock	90-100	
Shale + Rock	100-130	
Shale + soft Chalk	130-140	
Sand + Chalk	140-150	
Blue Shale	150-170	
Shell	170-193	
Rock	193-243	
Fine Sand	243-253	
Sand + Chalk	253-264	
Sand	264-272	
Chalk	272-275	


Information upon completion of well:

- (1) Diameter 2 inches. well
- (2) Total Depth 275 feet. 243'
- (3) Water Level 80 feet below top of ground.
- (4) Cased to 233', Size 2"
- (5) Screen: Size 2", Length 10'
- (6) Were any formations sealed against pollution?
_____ yes, no.

If YES depth of formation _____

Why _____

Drillers Remarks: _____

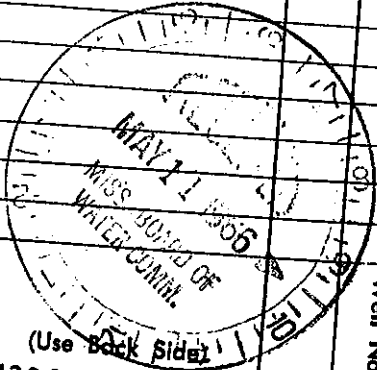

Well No. _____

(Use Back Side)

Mail this copy to Board of Water Commissioners 429 Miss. St. Jackson, Miss.