

HINDS
P 201D
5-11-66

MISSISSIPPI BOARD OF WATER COMMISSIONERS

WATER WELL DRILLERS LOG

Date: 11 May, 19 66, Driller: WATERWELLS, INC.

County HINDS

(1) Owner of Land: T. G. Wright

(Name)

Raymond, Miss.

(Address)

(2) Location: 1/4, 1/4, Sec. T 34 R 34

6 miles SW of Raymond
(distance) (direction) (Nearest Town)

(3) Topography: Hilly
(Hilly) (Flat) (Level)

(4) Purpose of Well: Domestic Home
(Domestic Irrigation
Municipal, Industrial, Other)

Description & Color of Materials
Sand, Clay, Red Clay, Shell, etc.

Thick-
ness
Feet

Depth
Feet

Weathered sandy clay	0	15
Redish sand	15	40
White-Bluish white clay	40	122
Greyish fine sand & shale	122	185
Shale & sand streaks	185	273
Fine white sand	273	286
Blue clay	286	342 TD

Information upon completion of well:

(1) Diameter 4 inches.

(2) Total Depth 284 feet.

(3) Water Level 103 feet below top of ground.

(4) Cased to 284, Size 4 x 2

(5) Screen: Size 2, Length 15

(6) Were any formations sealed against pollution?

X yes, no.


If YES depth of formation top 10 ft.

Why

Drillers Remarks: Very fine sand

Split Screens (10') 173-183

(5') 274-279

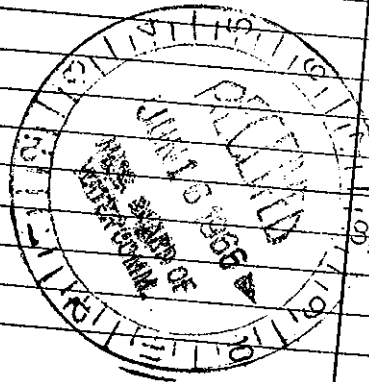

(Use Back Side)

Well No.

Mail this copy to Board of Water Commissioners 429 Miss. St. Jackson, Miss.