

Hinds  
P 2011  
9-66

MISSISSIPPI BOARD OF WATER COMMISSIONERS

WATER WELL DRILLERS LOG

Date: 9/17/1966, Driller: Water Wells, Inc. County Hinds  
(When well drilled) (Name) (Where well is located)

(1) Owner of Land: R. H. Liggett  
(Name)  
Rt. 1, Raymond, Miss.  
(Address)  
 (2) Location SE 1/4, SW 1/4, Sec. 15 T41R3  
7 1/2 miles S.W. of Raymond  
(distance) (direction) (Nearest Town)  
 (3) Topography: (Flat)  
(Hilly) (Flat) (Level)  
 (4) Purpose of Well: Domestic Home  
(Domestic Irrigation Municipal, Industrial, Other)

Description & Color of Materials Sand, Clay, Red Clay, Shell, etc.	Thick- ness Feet	Depth Feet
weathered clay		0
white clay	25	25
blue clay	20	45
sand clay & shell	10	55
blue clay - red streaks	10	65
blue clay	20	85
fine grey sand	15	100
sandy shale	3	103
clay - some sand	22	125
clay - grey blue	20	145
sandy shale	35	180
hard lime rock	30	210
sandy rock	13	213
sand?	2	215
rock	4	219
soft rock sand	3	222
shaly sand	3	225
rock & streak	5	230
sand & sea shells	8	238
sand grey fine	48	286
shale mixed		

Information upon completion of well:

(1) Diameter 5 inches.  
 (2) Total Depth 287 feet. <sup>235</sup>  
 (3) Water Level 45 feet below top of ground.  
 (4) Cased to 5' 183', size 2" = 32'  
 (5) Screen: Size 10/3, Length 10' 2"  
 (6) Were any formations sealed against pollution?  
 yes, X no.

If YES depth of formation \_\_\_\_\_


Why \_\_\_\_\_

Drillers Remarks: \_\_\_\_\_

Yield in gpm: 6 gpm

Size pump: 1/2 hp

Type power: Submersible

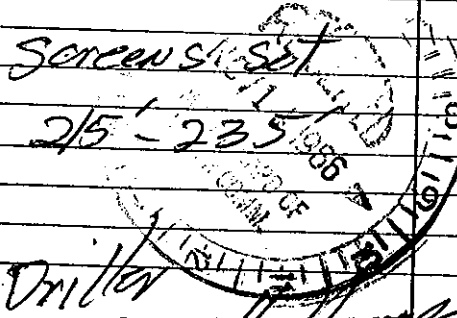

Mail this copy to Board of Water Commissioners 429 Miss. St. Jackson, Miss.