

Hinds
Q-27
6-66

MISSISSIPPI BOARD OF WATER COMMISSIONERS

Electrical Log by M.G.S.
WATER WELL DRILLERS LOG

U 050
#251

Date: 6-30- 1966, Driller: James McNeas County Hinds

(Name)


(1) Owner of Land: H.S. GAINSWORTH
(Name)
Terry miss
(Address)
N.E 1/4 NE 1/4, SE 1/4, Sec. 14 4^N 2^W
(2) Location: NE 1/4, SE 1/4, Sec. 14 4^N 2^W
5 miles S E of Raymond
(distance) (direction) (Nearest Town)
(3) Topography: (Hilly) (Flat) (Level)
(4) Purpose of Well: Domestic
(Domestic Irrigation
Municipal, Industrial, Other)

Description & Color of Materials Sand, Clay, Red Clay, Shell, etc.	Thick- ness Feet	Depth Feet
clay	20	20
Grey shale	20	40
Bluish shale	125	165
SAND & shale	6	171
Grey shale	141	312
Lime sh strks	43	355
SAND sh strks	8	363
Grey shale	2	365
SAND sh strks	15	380
Grey sh	16	396
SAND	2	398
Grey sh	9	407
Grey sh sd strks	20	427
Grey sh	5	432
SAND	7	439
Grey sh	8	447
Grey sh sd strks	23	470
SAND	15	485
Grey sh	2	487

Information upon completion of well:

(1) Diameter 2" inches.
(2) Total Depth 487' feet.
(3) Water Level 160 feet below top of ground.
(4) Cased to 464', Size 2"
(5) Screen: Size 2.008, Length 20
(6) Were any formations sealed against pollution?
yes, no,
If YES depth of formation _____

23 str 2" 464
2-2" 008 sss 20
1-1/2" 2" BPK 484
12
496

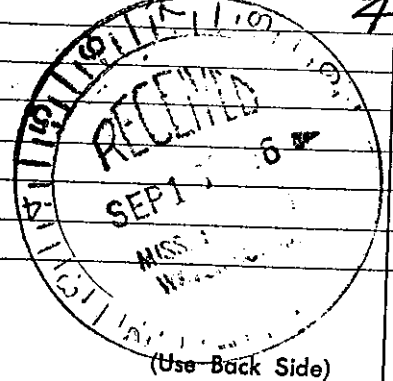

(Use Back Side)

Well No.

Mail this copy to Board of Water Commissioners 429 Miss. St. Jackson, Miss