

Hinds
 B29
 11-66
 Elec log 261

MISSISSIPPI
 BOARD OF WATER COMMISSIONERS
 416 North State Street
 Jackson, Mississippi 39201

WATER WELL DRILLERS LOG

11-2-66 date well completed
 Gordon - McNeas firm name
 Hinds county well located

LANDOWNER: H.M. McWilliams

description of formations encountered	from	to
SURFACE SOIL	0	10
Blue shale	10	318
SNd	318	320
Grey shale	320	363
POCK SH STRS	363	406
Grey sdy sh	406	412
SNd	412	429
Grey sdy sh	429	436
SNd	436	440
SNd sh STRS	440	471
SNd	471	479
Grey sh sdy STRS	479	519
Grey sh	519	538


REYMOND MISS
 (mailing address)

WELL LOCATION:
 sec. 23 T-4 N R- E
 S 2 W
 7 miles S.E. of REYMOND
 (distance) (direction) (nearest town)

WELL PURPOSE: HOME
 (home, irrigation, municipal, industrial)

WELL COMPLETION DATA:

- (1) diameter (inches) 3 x 2
- (2) total depth (feet) 538
- (3) static water level (feet) 141 below top of ground.
- (4) casing steel 3 x 2" (material), (depth) 3 x 2" If telescope see back.
- (5) screen 42' 399 (length), (depth to top) 1006 1 1/4 BRASS (size), (material)
- (6) pump 1/3 5 (HP), (yield gpm)
 Elec (type power)
- (7) electric log YES (yes or no)
 MISS G.S. (organization running log)
- (8) how well bottom plugged 1/4 plug

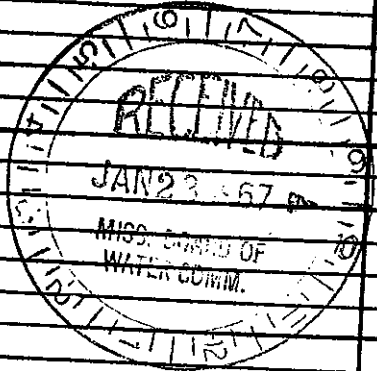

DRILLERS REMARKS:
 Water has
 NO COLOR