

HINDS

MISSISSIPPI BOARD OF WATER COMMISSIONERS

Q 2000

2-5-62

WATER WELL DRILLERS LOG

Date: 2/5, 1962, Driller: Johnnie Beasley County Hinds.

(Name)

(1) Owner of Land: G. W. Oldham  
(Name)  
226 W. Pascagoula, St. Jackson, Miss.  
(Address)  
This well located 15 miles West of  
(2) Location: 1/4, 1/4, Sec. 11/1 R 24  
Byram, Miss.  
15 miles West, of Byram,  
(distance) (direction) (Nearest Town)  
(3) Topography: X  
(Hilly) (Flat) (Level)  
(4) Purpose of Well: Domestic Home  
(Domestic Irrigation  
Municipal, Industrial, Other)

Description & Color of Materials Sand, Clay, Red Clay, Shell, etc.	Thick- ness Feet	Depth Feet
Chalk.	30-	30
Blue clay.	66-	96
Shale & stks. sand.	8-	104
Blue clay.	14-	118
Sand. (Screen setting.)	12-	130


Information upon completion of well:

- (1) Diameter 2 inches.
- (2) Total Depth 130 feet.
- (3) Water Level 100 feet below top of ground.
- (4) Cased to 120', Size 2"
- (5) Screen: Size 2", Length 10'
- (6) Were any formations sealed against pollution?  
yes, X no.

If YES depth of formation

Why

Drillers Remarks: Fair well.

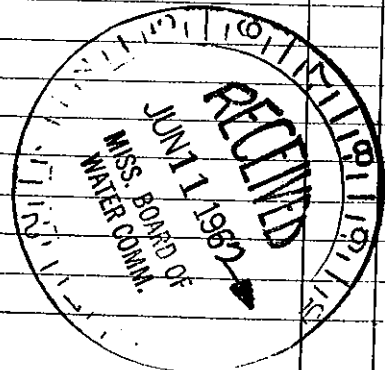

Well No.

(Use Back Side)

Mail this copy to Board of Water Commissioners 429 Miss. St. Jackson, Miss.