

HINDS MISSISSIPPI BOARD OF WATER COMMISSIONERS

Q 2003

8-63


WATER WELL DRILLERS LOG

R.G.

Date: AUG., 1963, Driller: MCNEECE DRILLING County HINDS

(Name Co.)

(1) Owner of Land: <u>W.R. NEWMAN</u> (Name)	Description & Color of Materials Sand, Clay, Red Clay, Shell, etc.	Thick- ness Feet	Depth Feet
<u>JACKSON MISS.</u> (Address)	<u>SURFACE Soil</u>	<u>6</u>	<u>6</u>
(2) Location: <u>1/4, SE 1/4, Sec. 6 T. 4 N. R. 2 W.</u>	<u>WHITE SHALE</u>		<u>24</u>
<u>5</u> miles <u>S.</u> , of <u>RAYMOND</u> , (distance) (direction) (Nearest Town)	<u>WHITE SAND</u>		<u>49</u>
(3) Topography: <u>HILLY</u> (Hilly) (Flat) (Level)	<u>GREY SHALE</u>		<u>87</u>
(4) Purpose of Well: <u>DOMESTIC HOME</u> (Domestic Irrigation Municipal, Industrial, Other)	<u>SHALE + SAND</u>		<u>109</u>
Information upon completion of well:	<u>SHALE</u>		<u>152</u>
(1) Diameter <u>4x2"</u> inches.	<u>SHALE + SAND</u>		<u>205</u>
(2) Total Depth <u>346</u> feet.	<u>ROCK LEDGES</u>	<u>45</u>	<u>250</u>
(3) Water Level <u>70</u> feet below top of ground.	<u>SHALE, SHELL & SAND</u>		<u>262</u>
(4) Cased to <u>270</u> ³²¹ , Size <u>4"</u> <u>270'-346'-2"</u>	<u>SHALE</u>		<u>288</u>
(5) Screen: Size <u>2"</u> , Length <u>25</u> .	<u>SAND (COARSE)</u>		<u>293</u>
(6) Were any formations sealed against pollution? <u>no</u>	<u>SHALE</u>		<u>315</u>
If YES, depth of formation _____	<u>SAND</u>	<u>20</u>	<u>335</u>
Why _____	<u>SHALE</u>	<u>12</u>	<u>347</u>
Drillers Remarks: _____			

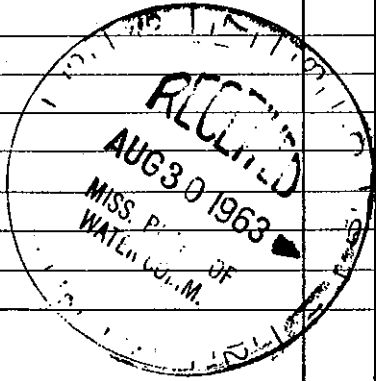

Well No. 59

(Use Back Side)

Mail this copy to Board of Water Commissioners 429 Miss. St. Jackson, Miss.