

HINDS MISSISSIPPI BOARD OF WATER COMMISSIONERS

Q 2005


8-1-64

WATER WELL DRILLERS LOG

Date: 8-1, 1964, Driller: James M. Nices County: HINDS

(Name)

(1) Owner of Land	Description & Color of Materials Sand, Clay, Red Clay, Shell, etc.	Thick- ness Feet	Depth Feet
Hunter Yarborough (Name) JACKSON MISS (Address)	Clay	30	30
(2) Location: 1/4, 1/4, Sec. T. 24 R. 24 W. 2	Blue shale	80	110
8 miles S.E. of REYNOLDS (distance) (direction) (Nearest Town)	Grey sh sd STKS	30	140
(3) Topography: <input checked="" type="checkbox"/> (Hilly) <input type="checkbox"/> (Flat) <input type="checkbox"/> (Level)	Grey shale	70	210
(4) Purpose of Well: Domestic Home (Domestic Irrigation Municipal, Industrial, Other)	Grey sdy sh	130	340
Information upon completion of well:	Rock sh STKS	18	358
(1) Diameter 4" x 2" inches.	Rock	19	377
(2) Total Depth 438 feet.	Grey shale	2	379
(3) Water Level 117 feet below top of ground.	Grey sdy sh	10	389
(4) Cased to 386 4/8, Size 4" x 2"	SEND	9	398
(5) Screen: Size 2.008, Length 20'	Grey sdy sh	10	408
(6) Were any formations sealed against pollution?	SEND	10	418
yes, <input checked="" type="checkbox"/> no.	Grey sdy sh	20	438
If YES depth of formation	12 STS 4"	255	
Why	1 4" x 2" SW edge	1	
Drillers Remarks:	17 STS 2"	156	
	1.2" .008 SSS screen	130	
	1.2" .008 SSS	286	
	1.2" .008 SSS	10	
	1.2" .008 SSS	396	
	1.2" .008 SSS	9	
	1.2" .008 SSS	405	
	1.2" .008 SSS	10	
	1.2" .008 SSS	415	
	1.2" .008 SSS	8	
	1.2" .008 SSS	423	
	1.2" .008 SSS		
	1.2" .008 SSS		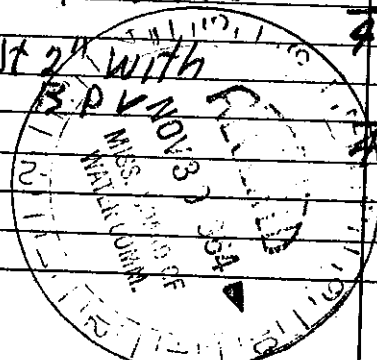
(Use Back Side)

Well No.

Mail this copy to Board of Water Commissioners 429 Miss. St. Jackson, Miss