

Hinds MIS
 @ 2006
 8-66

WATER WELL DRILLERS LOG


Date Aug, 1966, Driller: M^cKay County Hinds
 (Name)

(1) Owner of Land A.C. Guffin Jr.
 (Name)
Jackson Miss
 (Address)
 (2) Location SE 1/4, NE 1/4, Sec. 13 T4N R12W
42
12 miles S, of Jackson
 (distance) (direction) (Nearest Town)
 (3) Topography: (Hilly) (Flat) (Level)
 (4) Purpose of Well: Home
 (Domestic Irrigation
 Municipal, Industrial, Other)

Description & Color of Materials Sand, Clay, Red Clay, Shell, etc.	Thick- ness Feet	Depth Feet
Red clay	0	20
Red clay	20	40
Red Sand	40	60
Blue clay	60	160
Sandy clay	160	200
Fine Sand	200	250
Blue clay	250	380
Brown shale	380	480
Blue clay	480	520
Shale - Sand	520	560
Blue clay	560	580
Loam	580	585
Clay	585	610
Loam	610	620
Fine Sand	620	680
Med Sand	680	700
Med sand	700	720
1 1/2 HP. Sub Pump		
Set 210		

Information upon completion of well:

(1) Diameter 4x2 inches.
 (2) Total Depth 720 feet.
 (3) Water Level 165 feet below top of ground.
 (4) Cased to 315-690, Size 4"
 (5) Screen: Size 208, Length 30
 (6) Were any formations sealed against pollution?
 _____ yes, no.
 If YES depth of formation _____
 Why _____
 Drillers Remarks: _____

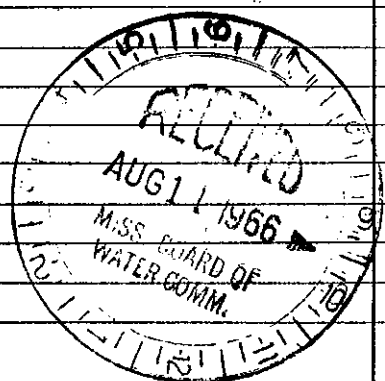

(Use Back Side)

Well No.

Mail this copy to Board of Water Commissioners 429 Miss. St. Jackson, Miss