


Hinds
 Q 2007
 9-66

MISSISSIPPI BOARD OF WATER COMMISSIONERS

WATER WELL DRILLERS LOG

Date: 9-28, 1966, Driller: HALL DRILLING CO County HINDS
 (Name)

| (1) Owner of Land: <u>JOE T. DEHMER</u> (Name) | Description & Color of Materials Sand, Clay, Red Clay, Shell, etc. | Thick- ness Feet | Depth Feet |
|--|---|------------------------|---------------|
| <u>P.O. BOX 1012 JACKSON MISS</u> (Address) | <u>SURFACE SOIL</u> | <u>7</u> | <u>7</u> |
| (2) Location: <u>SW 1/4, SE 1/4, Sec 26 T4N R2W</u> | <u>GRAVEL</u> | <u>2</u> | <u>9</u> |
| <u>5</u> miles <u>S.E.</u> , of <u>RAYMOND</u> (distance) (direction) (Nearest Town) | <u>ROCK</u> | <u>1</u> | <u>10</u> |
| (3) Topography: <u>HILLY</u> (Hilly) (Flat) (Level) | <u>HARD SHALE</u> | <u>30</u> | <u>40</u> |
| (4) Purpose of Well: <u>DOMESTIC</u> Home (Domestic Irrigation Municipal, Industrial, Other) | <u>ROCK + BLUE SHALE</u> | <u>60</u> | <u>100</u> |
| Information upon completion of well: | <u>SHALE</u> | <u>85</u> | <u>185</u> |
| (1) Diameter <u>4 X 2</u> inches. | <u>SAND + SHALE</u> | <u>16</u> | <u>201</u> |
| (2) Total Depth <u>996</u> feet. | <u>MED GRAIN SAND</u> | <u>49</u> | <u>250</u> |
| (3) Water Level <u>190</u> feet below top of ground. | <u>HARD SHALE</u> | <u>22</u> | <u>272</u> |
| (4) Cased to <u>350 976</u> , Size <u>4"</u> | <u>ROCK + SHALE</u> | <u>60</u> | <u>332</u> |
| (5) Screen: Size <u>2</u> , Length <u>20</u> | <u>SHALE</u> | <u>40</u> | <u>372</u> |
| (6) Were any formations sealed against pollution? _____ yes, _____ no. | <u>SAND + SHALE</u> | <u>40</u> | <u>412</u> |
| If YES depth of formation _____ | <u>YAZOO CLAY</u> | <u>440</u> | <u>852</u> |
| Why _____ | <u>MOODY BRANCH</u> | <u>17</u> | <u>871</u> |
| Drillers Remarks: _____ | <u>SHALE</u> | <u>35</u> | <u>906</u> |
| | <u>SAND SHALE + LIE</u> | <u>13</u> | <u>919</u> |
| | <u>SHALE ROCK + SAND</u> | <u>21</u> | <u>940</u> |
| | <u>ROCK SHALE + LIE + SAND</u> | <u>7</u> | <u>947</u> |
| | <u>COURSE SAND</u> | <u>44</u> | <u>991</u> |
| | <u>SHALE</u> | <u>5</u> | <u>996</u> |

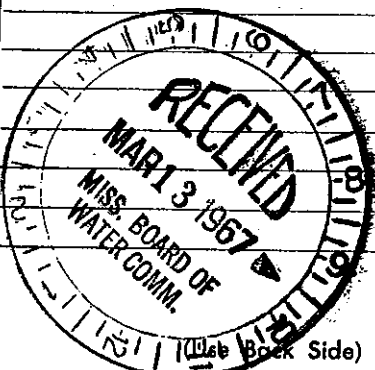

36 Well No.

Mail this copy to Board of Water Commissioners 429 Miss. St. Jackson, Miss