

HINDS MISSISSIPPI BOARD OF WATER COMMISSIONERS

R

R 302


11-11-60

WATER WELL DRILLERS LOG

Date: 11/11/60, 1960, Driller: MSNEECE DRILLING Co. County: HINDS

(Name)

	Description & Color of Materials Sand, Clay, Red Clay, Shell, etc.	Thick- ness Feet	Depth Feet
(1) Owner of Land: LEWIS E. DAVIS (Name)	CLAY SOIL	6	0
RED TERRY MISS. (Address)	SAND	8	6
(2) Location: SW 1/4, Sec. 17 T. 4 N. W.	WHITE SHALE	16	14
4 miles SW of BYRAM, (distance) (direction) (Nearest Town)	GREY SHALE	35	30
(3) Topography: HILLY (Hilly) (Flat) (Level)	SHALE + SAND	30	65
(4) Purpose of Well: DOMESTIC (Domestic Irrigation Municipal, Industrial, Other)	GREY SAND	37	95
Information upon completion of well:	GREY SHALE	108	132
(1) Diameter 4x2 inches.	ROCK LEDGES	40	240
(2) Total Depth 395 feet.	SHALE + SAND	23	280
(3) Water Level 130 feet below top of ground.	SHALE	22	303
(4) Cased to 282, Size 4" 282-395-2"	SAND + SHALE	51	325
(5) Screen: Size 2, Length 20	GREY SAND	19	376
(6) Were any formations sealed against pollution?			395
yes, <input checked="" type="checkbox"/> no.			
If YES depth of formation			
Why			
Drillers Remarks:			

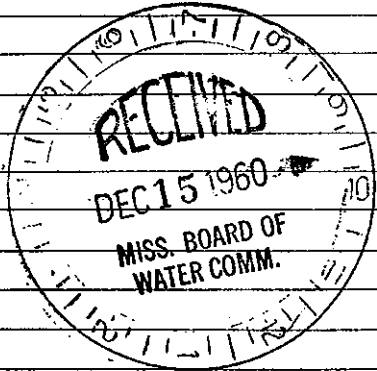

(Use Back Side)

Well No. 8

Mail this copy to Board of Water Commissioners 429 Miss. St. Jackson, Miss.