

HINDS MISSISSIPPI BOARD OF WATER COMMISSIONERS

R

WATER WELL DRILLERS LOG

H-308

9-61

Date: SEPT, 1961, Driller: MCNEECE DRILLING Co., County HINDS

(Name)

(1) Owner of Land: <u>W.B. BOWERS</u> (Name)	Description & Color of Materials Sand, Clay, Red Clay, Shell, etc.	Thick- ness Feet	Depth Feet
P.O. Box 2162, JACKSON MISS	SURFACE CLAY	6	0
(Address) SW 1/4 of SE 1/4 & SE 1/4 of SW 1/4 of SEC 21,	GREY SHALE	65	6
(2) Location: W 1/2 NE 1/4, Sec. 28 T. R.	FINE SAND	26	71
5 miles N of TERRY	GREY SHALE	128	97
(distance) (direction) (Nearest Town)	ROCK LEDGES	40	225
(3) Topography: <u>HILLY</u>	SAND	25	265
(Hilly) (Flat) (Level)			290
(4) Purpose of Well: <u>DOMESTIC</u> (Domestic Irrigation Municipal, Industrial, Other)			


Information upon completion of well:

- (1) Diameter 4" X 2" inches.
- (2) Total Depth 290 ^{1 1/2} feet.
- (3) Water Level 120 feet below top of ground. _{270 well}
- (4) Cased to 250 FT, Size 4", _{250'-290' -2"}
- (5) Screen: Size 2", Length 20 FT.
- (6) Were any formations sealed against pollution?
 yes, no.

If YES depth of formation _____

Why _____

Drillers Remarks: _____

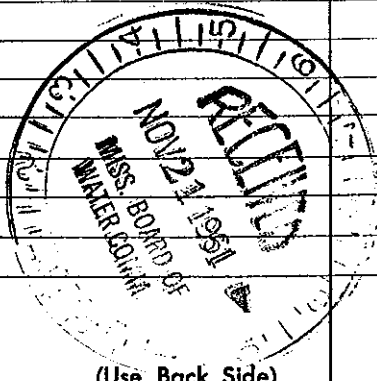

(Use Back Side)

Well No. 20

Mail this copy to Board of Water Commissioners 429 Miss. St. Jackson, Miss