

HINDS  
R

MISSISSIPPI BOARD OF WATER COMMISSIONERS

12-18-61

WATER WELL DRILLERS LOG

R-303

Date: 12-18-61, 19\_\_\_, Driller: James McNeas County Hinds

(Name)

(1) Owner of Land: DR. C. E. WARD  
(Name)  
JACKSON MISSISSIPPI.  
(Address)

(2) Location: NW 1/4, SE 1/4, Sec. 7 A<sup>N</sup> R<sup>E</sup>  
8 miles south of JACKSON  
(distance) (direction) (Nearest Town)

(3) Topography:  (Hilly)  (Flat)  (Level)

(4) Purpose of Well: Domestic  
(Domestic Irrigation, Municipal, Industrial, Other)

Description & Color of Materials Sand, Clay, Red Clay, Shell, etc.	Thick- ness Feet	Depth Feet
SURFACE soil	10	10
SAND	2	12
CLAY	8	20
SAND	15	35
CLAY	20	55
ROCK	1	56
Blue shale	24	80
Grey shale	70	150
SAND sh STKS	10	160
Grey shale	15	175
Grey sandy shale	5	180
SAND sh STKS	30	210
SAND	35	245
Grey shale	352	597
ROCK	1	598
SAND	12	610
Grey shale	15	625
Grey sh sd STKS	35	660
SAND	55	715
SAND sh STKS - Lignite	6	721
15 Jts 4" pipe		315'
1 4"x2" swab		1
17 Jts 2" pipe		357
3-2".008 s.s screens		673
		30
		703
1-2" Nipple - B.P.V.		1
		704
Pipe OFF bottom		17
T. D.		721

Information upon completion of well:

(1) Diameter 4"x2" inches.

(2) Total Depth 721' feet.

(3) Water Level 157' feet below top of ground.

(4) Cased to 673' Size 3 1/2" 4" 357' 2"


(5) Screen: Size 2".008, Length 30'

(6) Were any formations sealed against pollution?  
yes, no.

If YES depth of formation

Why

Drillers Remarks: No color

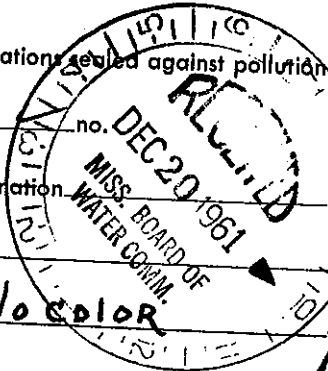

Well No.

(Use Back Side)