


Hinds
R 87
4-66

MISSISSIPPI BOARD OF WATER COMMISSIONERS
Electrical Log, by M. G. S.
WATER WELL DRILLERS LOG

Elog# 385

Date: 4-27, 1966, Driller: James McNeese County Hinds

		Description & Color of Materials Sand, Clay, Red Clay, Shell, etc.	Thick- ness Feet	Depth Feet
(1) Owner of Land: <u>S. V. Guess</u> (Name)		Surface soil	6	6
<u>Terry Miss</u> (Address)		SAND	37	43
(2) Location: <u>S-1/4, NE 1/4, Sec. 33 A^N R¹ W¹</u> <u>23</u> miles <u>West</u> of <u>Terry</u> (distance) (direction) (Nearest Town)		Grey sh sd stks	40	83
(3) Topography: <input checked="" type="checkbox"/> (Hilly) <input type="checkbox"/> (Flat) <input type="checkbox"/> (Level)		Grey sh	7	90
(4) Purpose of Well: <u>Domestic</u> (Domestic Irrigation Municipal, Industrial, Other)		SAND	5	95
Information upon completion of well:		Grey sh	60	155
(1) Diameter: <u>4" x 2"</u> inches.		Rock	1	156
(2) Total Depth: <u>320</u> feet.		Grey shale	3	159
(3) Water Level: <u>150</u> feet below top of ground.		Rock sh stks	21	180
(4) Cased to <u>297'</u> , Size <u>4" x 2"</u>		SAND	8	188
(5) Screen: Size <u>2" .007</u> , Length <u>20'</u>		Grey sh	79	267
(6) Were any formations sealed against pollution? <input type="checkbox"/> yes, <input checked="" type="checkbox"/> no.		lime sh stks	20	287
If YES depth of formation _____		Shale	1	288
Why _____		lime - sh stks	9	297
Drillers Remarks: <u>White Water</u>		SAND	21	318
		Grey sh	2	320
		13 JTS 4"		273
		1 4" x 2" swedae		1
		1 JT 2"		274
		1 - 2"		21
		2. 2x10" .007 ss screen		2
				297
				20
		1-JT 2" & 8 BK 10"		317
				2
				325

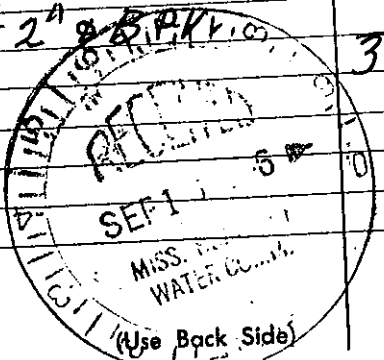

Well No.

Mail this copy to Board of Water Commissioners 429 Miss. St. Jackson, Miss.