

HINDS MISSISSIPPI BOARD OF WATER COMMISSIONERS
R-89 Elect Log. Miss Geological Survey
1-12-65 WATER WELL DRILLERS LOG #200

Date: 1-12-65, Driller James McNeese County Hinds
 (Name)

(1) Owner of Land: COURTNEY
 (Name)
Terry Miss
 (Address)
 (2) Location: SW 1/4, SW 1/4, Sec. 17 A R1
8 miles NW, of Terry
 (distance) (direction) (Nearest Town)
 (3) Topography: (Hilly) (Flat) (Level)
 (4) Purpose of Well: Domestic
 (Domestic Irrigation, Municipal, Industrial, Other)


Description & Color of Materials Sand, Clay, Red Clay, Shell, etc.	Thick- ness Feet	Depth Feet
SURFACE SOIL	10	10
SAND	5	15
Blue shale	85	100
SAND	40	140
Grey shale	36	176
Grey sdy sh	27	203
Grey shale	51	254
Rock id strk	38	292
Grey sdy sh	3	295
SAND - sh strk	11	306
Grey sh sd strk	82	388
SAND	24	412
Grey green sh	18	430

Information upon completion of well:

(1) Diameter 4x2 inches.
 (2) Total Depth 430 feet.
 (3) Water Level 130 feet below top of ground.
 (4) Cased to 384', Size 4x2
 (5) Screen: Size 2.007, Length 20
 (6) Were any formations sealed against pollution?
 _____ yes, no.

13 fts 4"	274
1 4x2 swedge	1
5 fts 2"	275
1 - -	105
	4
	384
2-10' 007 sss	20
1-2" teal pipe - B.P.V.	6
	410

If YES depth of formation _____
 Why _____
 Drillers Remarks: _____

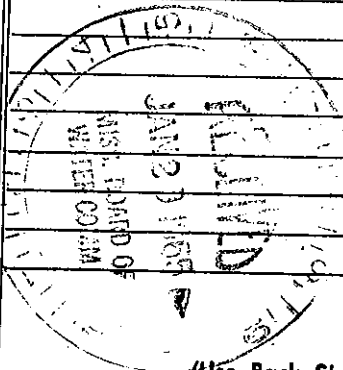

(Use Back Side)

Well No.