

HINDS

R91

7-7-65

MISSISSIPPI BOARD OF WATER COMMISSIONERS

Elec Log Miss Geological Survey

WATER WELL DRILLERS LOG

Date: 7-7-65, Driller: James McNEES County HINDS

(Name)

(1) Owner of Land: J.T. Richardson
Route 1-Box 38 Terry
(Name)
(Address)

(2) Location: NE 1/4, Sec. 17, T4N, R1W
4 miles West of BYREM
(distance) (direction) (Nearest Town)

(3) Topography: (Hilly) (Flat) (Level)

(4) Purpose of Well: Domestic
(Domestic Irrigation, Municipal, Industrial, Other)

Description & Color of Materials Sand, Clay, Red Clay, Shell, etc.	Thick- ness Feet	Depth Feet
SURFACE SOIL	10	10
SAND	20	30
Blue shale	55	85
SAND	20	105
Blue Grey sh	75	180
ROCK	38	218
Grey sdy sh	32	250
SAND	4	254
Grey shale	463	717
Grey sdy sh	44	761
Grey shale	86	847
Grey sh sd stks	22	869
SAND	17	886
Grey shale	5	891
Grey sdy sh sd stks	22	913
Grey SAND	7	920
SAND	11	931
Grey shale	4	935
Grey sdy sh sd stks	141	1076
15 Jts 4		217
1 4x2 swedge		1
28 Jts 2"		318
		590
		908
2-2" 10' 008 565		20
		928
1-Jt 2"		100
8 B.P.V.		28

Information upon completion of well:


- (1) Diameter: 4" x 2" inches.
- (2) Total Depth: 1076' feet.
- (3) Water Level: 211 feet below top of ground.
- (4) Cased to: 908, Size: 4x2
- (5) Screen: Size: 2" 008, Length: 20

(6) Were any formations sealed against pollution?
yes, no.

If YES depth of formation _____

Why _____

Drillers Remarks: _____

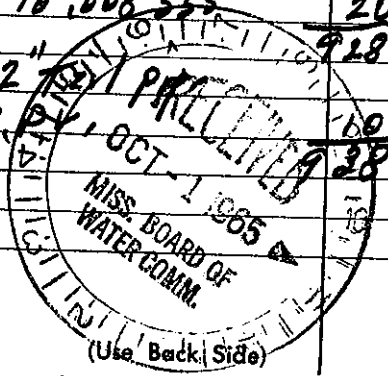

Well No. _____

Mail this copy to Board of Water Commissioners 429 Miss. St. Jackson, Miss.