

MISSISSIPPI BOARD OF WATER COMMISSIONERS

Hinds
R 98
6-28-66

ELOG # 255

WATER WELL DRILLERS LOG

CODED

Date: 28 June, 1966, Driller: WATERWELLS, INC. County: Hinds

(Name)

(1) Owner of Land: James M. Daniels (Name)	Description & Color of Materials Sand, Clay, Red Clay, Shell, etc.	Thick- ness Feet	Depth Feet
Rt. 1, Terry, Miss. (Address)	Weathered clay	0	8
(2) Location: 1/4, 1/4, Sec. 32 T4R1	Hard sand ston -clay stks.	8	22
2 miles West of Wynndale (distance) (direction) (Nearest Town)	rock - med to hard white	22	26
(3) Topography: Hilly (Hilly) (Flat) (Level)	white clay-sandy streaks	26	181
(4) Purpose of Well: Domestic (Domestic Irrigation Municipal, Industrial, Other)	Grey med. gr. sand	161	186
	Bluish to grey clay	186	210
	Grey-fine to Med. sand	210	230
	(20' of 4" screen set in top sand at 165-185')		

Information upon completion of well:

(1) Diameter 4 inches.

(2) Total Depth 185 feet.

(3) Water Level 41 feet below top of ground.

(4) Cased to 185, Size 4"

(5) Screen: Size 4", Length 20'


(6) Were any formations sealed against pollution?
 yes, no.

If YES depth of formation top 10'

Why

Drillers Remarks: Well test 70 gpm

Pumping rate 23gpm

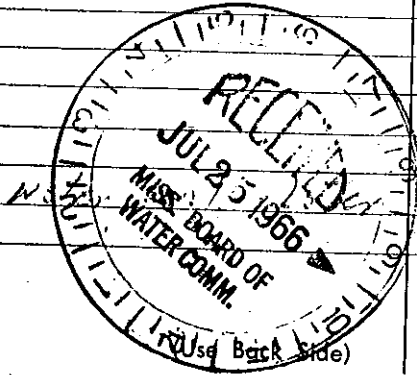

Well No.

Retain this copy for your office files.