

HINDS MISSISSIPPI BOARD OF WATER COMMISSIONERS

R2000


WATER WELL DRILLERS LOG

6-61

Date: JUNE, 1961, Driller: MCNEECE DRILLING Co County HINDS

(Name)

(1) Owner of Land: <u>SANCTIFIED CHURCH OF CHRIST</u> (Name)	Description & Color of Materials Sand, Clay, Red Clay, Shell, etc.	Thick- ness Feet	Depth Feet
<u>RT. 2, TERRY MISS.</u> (Address)	<u>CLAY SOIL</u>	<u>5</u>	<u>0</u>
<u>NW 1/4, SE 1/4 and NE 1/4 & SW 1/4</u> (2) Location: <u>1/4, 1/4, Sec. 33 T4 R1W</u>	<u>RED SAND</u>	<u>20</u>	<u>5</u>
<u>3</u> miles <u>NORTH</u> , of <u>TERRY</u> (distance) (direction) (Nearest Town)	<u>WHITE SHAKE</u>	<u>15</u>	<u>25</u>
(3) Topography: <u>HILLY</u> (Hilly) (Flat) (Level)	<u>RED SAND</u>	<u>6</u>	<u>40</u>
(4) Purpose of Well: <u>CHURCH</u> (Domestic Irrigation Municipal, Industrial, Other)	<u>SHALE</u>	<u>4</u>	<u>46</u>
Information upon completion of well:	<u>GREY SAND</u>	<u>22</u>	<u>50</u>
(1) Diameter <u>4x2</u> inches.	<u>ROCK</u>	<u>5</u>	<u>77</u>
(2) Total Depth <u>384</u> ^{hole} feet.	<u>GREY SHALE</u>	<u>50</u>	<u>82</u>
(3) Water Level <u>140</u> feet below top of ground.	<u>ROCK</u>	<u>10</u>	<u>172</u>
(4) Cased to <u>250</u> , Size <u>4"</u> <u>250' - 384' - 2"</u>	<u>SAND</u>	<u>12</u>	<u>182</u>
(5) Screen: Size <u>2"</u> , Length <u>20'</u>	<u>GREY SHALE</u>	<u>77</u>	<u>194</u>
(6) Were any formations sealed against pollution? <u>no</u>	<u>ROCK LEDGES</u>	<u>29</u>	<u>271</u>
If YES depth of formation _____	<u>SAND</u>	<u>62</u>	<u>300</u>
Why _____	<u>SHALE & SAND</u>	<u>22</u>	<u>362</u>
Drillers Remarks: _____			<u>384</u>

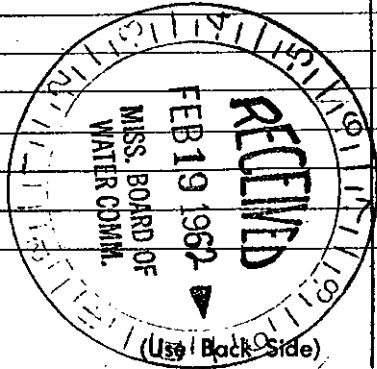

Well No. 14